

Name Dr. Thomas K. Richards

Service No. ~~26~~ 2579

Address 124 Spring St.

Location 124 Spring St

Kind of Pipe

Size

Size of Main

~~Repair - Renewal~~ - New Service

Location

Date	Material	Amount	Total	Date	Amount
8/9/32 <i>Comm. 5.45 10-18-32</i>	7 Hrs. Labor @ .55	3 85			
	1 " "	<u>60</u>	\$4 45	Oct. 22 1932 - Cash	5 45
	Trucking		<u>1 00</u>		
			\$5 45		
	Trench & Pipe by owner.				
	Labor				

Hadley Press, Inc., Lexington

DATE _____

TOWN OF LEXINGTON—BOARD OF PUBLIC WORKS

WATER DIVISION

The undersigned applies for a supply of water at No. _____ St. and hereby agrees to comply with the rules and regulations as now, or at any future time, established by the Board of Selectmen.


Am't. of Estimate \$ _____

Owner _____

Am't. Paid \$ _____

Address _____

Builder _____

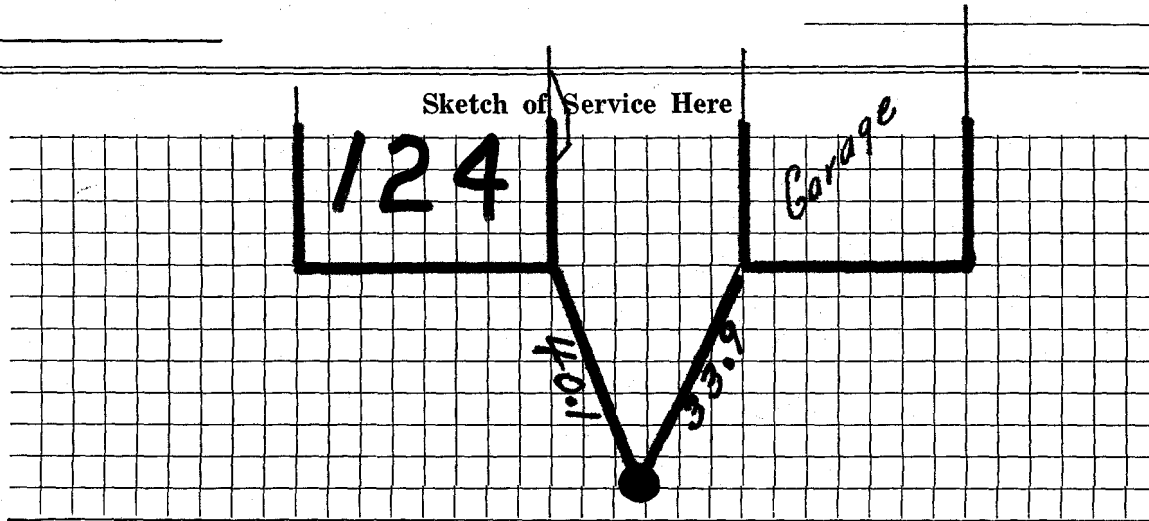

Connection made in _____ Street.

Work completed _____ 19

Remarks: