

WATER SERVICE RECORD

Name Northeast Automatic Sprinkler Co. Inc.

Service No. 76

Address 125 Spring St.

Location

Repair—Renewal—New Service W.O. #7712

JAN 27 1969

Date	Material	Amount	Total	Date	Amount
12/30/68	Labor	44 06		11-30-66	335 00
1/15/69	"	111 04		11-30-66	747 10
1/16/69	"	104 38			
1/17/69	"	182 45			1079 10
1/20/69	"	122 08	563 99		
	10% O.H.		56 40		
	37' x 8" Water pipe	3.74	138 38		
	1-8" Bend		33 75		
	1-8" Solid Sleeve		26 40		
	1 Gate Box		19 75		
	1/2 Ton Cold Patch	5.50	1 38		
	17 Lbs. Mineral lead	.17 1/2	12 25		
	10 Lbs. Jute	.78	7 80		
	9 Hrs. trucking @ 3.00	3.00	27 00		
	18 " shovel @ 6.50	6.50	117 00		
	15 " compressor @ 5.00	5.00	75 00		
8/8/96	12x8 T S + G		1079 10		
	8" DIP				
					Bill sent 744.10


DATE _____

TOWN OF LEXINGTON -- BOARD OF PUBLIC WORKS

WATER DIVISION

Sketch of Service Here

125

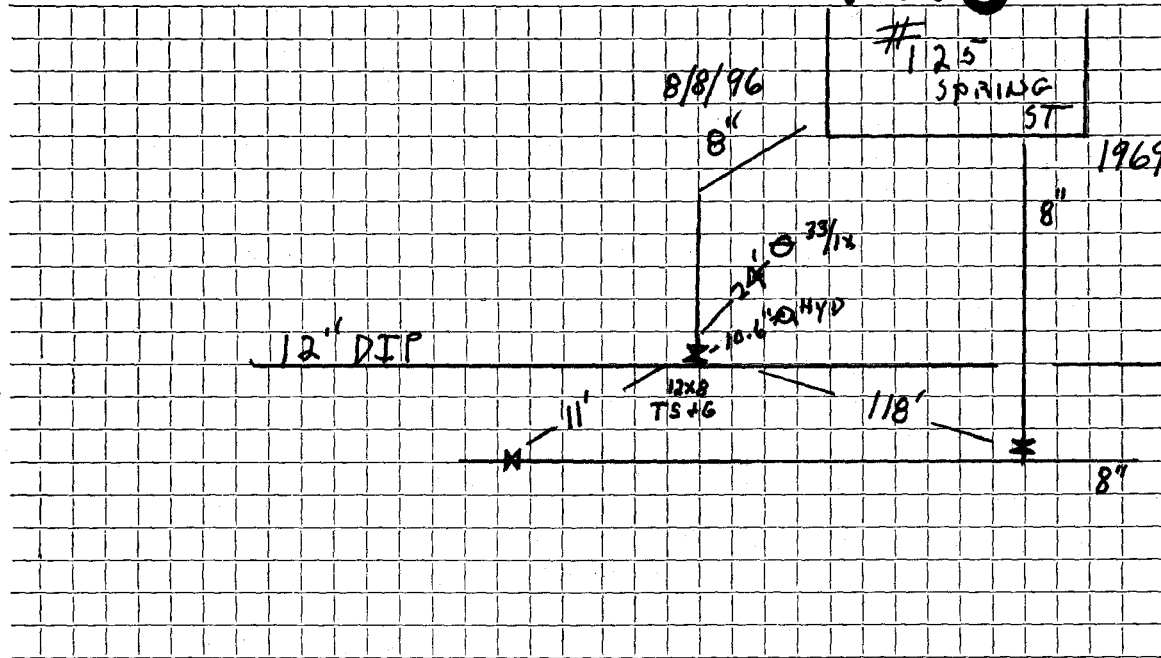

Connection made in SPRING ST Street. Work completed 8/8/96

Remarks:

.....

.....