

Name Dr. Tom. K. Richards

Service No. 90

Address 128 Spring St.

Location 128 Spring St

Kind of Pipe

Size

Size of Main

Repair—Renewal—New Service

Location

| Date | Material | Amount | Total | Date | Amount |
|----------|---------------------------------|--------|-------|--------------|--------|
| 11/23/31 | 1 2"x1 1/2" L.L. Coup. | 60 | | A.P. 2-24-32 | |
| | 4 1 1/2" Br. Sp. Nip. @ .25 | 1 00 | | | |
| | 2 1 1/2" I. to I. L.L. Unions @ | 1 70 | | | |
| | Trucking | 75 | | | |
| | Chge. build. pit. | 15 00 | 19 05 | | |
| | 7 Hrs. Labor @ .55 | 3 85 | | | |
| | 3 " " @ .60 | 1 80 | 5 65 | | |
| | 15% overhead | | 85 | | |
| | | | 25 55 | | |
| | Labor | | | | |

Hadley Press, Inc., Lexington

DATE _____

TOWN OF LEXINGTON — BOARD OF PUBLIC WORKS

WATER DIVISION

The undersigned applies for a supply of water at No. _____ St. and hereby agrees to comply with the rules and regulations as now, or at any future time, established by the Board of Selectmen.

Am't. of Estimate \$ _____


Owner _____

Am't. Paid \$ _____

Address _____

Builder _____

Sketch of Service Here

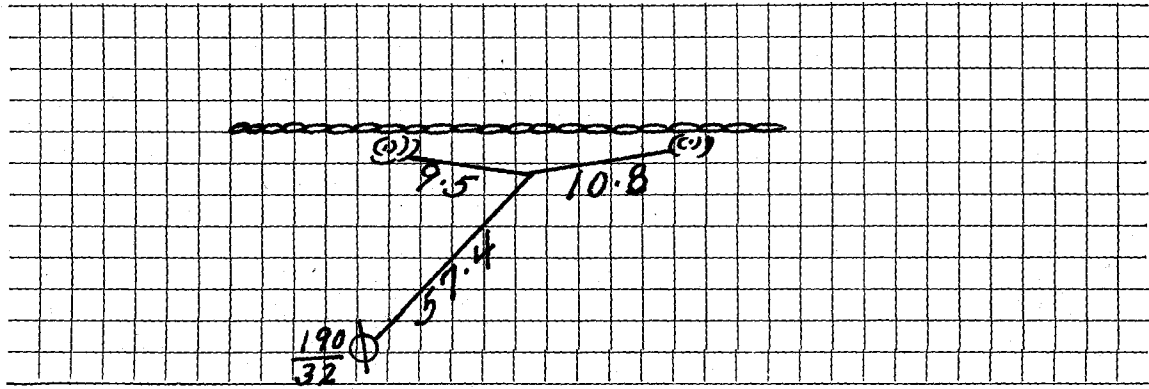

Connection made in _____ Street.

Work completed _____ 19

Remarks: