

Name Mr. Henning Swenson

Service No. \neq 2581

Address Marrett Road

~~129~~ 129 Spring St.

Location ¹²⁹ Spring St. Cottage

Kind of Pipe

Size

Size of Main

~~REPAIR-RENEW~~ - New Service

Location

Date	Material	Amount	Total	Date	Amount
C. 2-18-30 for 38.77	37' 1" C.L. Pipe @.27	9 99			
	2 1" L.L. Coup. @.25	50		Mar. 6 1930 - Cash	38 77
	2 1" L.L. Ells @.35	70			
	1 1" Br. Sp. Nip.	25			
	1 S & W	3 00			
	Trucking	75	15 19		
10/17/29	34 Hrs. Labor @.55	18 70			
	3 " " @.60	1 80	20 50		
	15% Overhead		3 08		
			38 77		
	Labor				

Hadley Press, Inc. Lexington

DATE _____

TOWN OF LEXINGTON—BOARD OF PUBLIC WORKS

WATER DIVISION

The undersigned applies for a supply of water at No. _____ St. and hereby agrees to comply with the rules and regulations as now, or at any future time, established by the Board of Selectmen.


Am't. of Estimate \$ _____

Owner _____

Am't. Paid \$ _____

Address _____

Builder _____

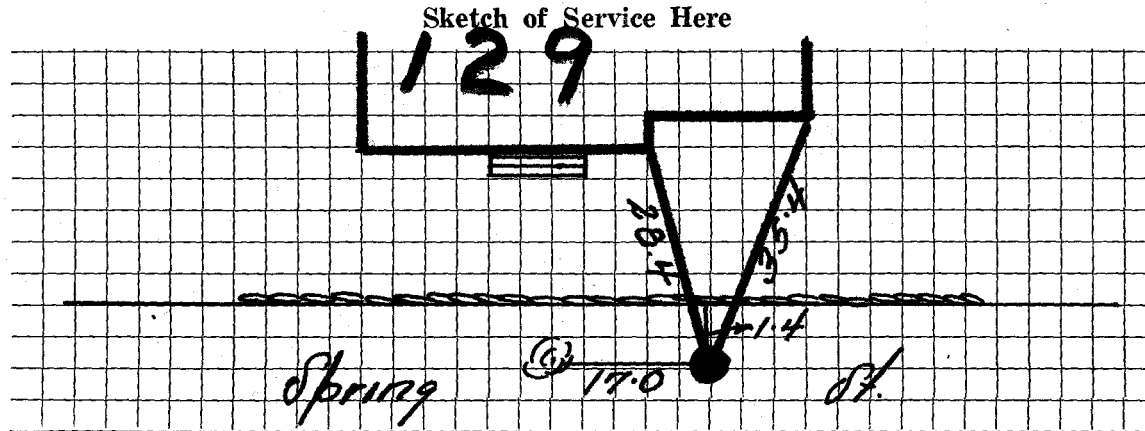

Connection made in _____ Street.

Work completed _____ 19

Remarks: