

WATER SERVICE RECORD

Name Burroughs Corp. (Ingraham & Company)

Service No. 128

Address 142 Spring Street

Location

~~Water Service~~ - New Service W.O. #9332 installed by Town


FEB 15 1965

Date	Material	Amount	Total	Date	Amount
11-13-64	Labor	61.60		11-29-64	Deposit 100.00
	10% O.H.	6.16	67.76		
	16' 2" Copper tubing @1.30		20.80		
	1 1/2 hrs. Town Shovel @6.50		9.75		CURB TO MAIN
	1 hr. Town Truck		3.00		9' 2" Copper tubing @1.30
			101.31		1 2" Corp Cock
			117.75		1 2 x 12 Service Saddle
			219.06		1 2" Oriseal Curb Cock
					1 2" Copper Iron Femal Adapter
					5 x 3 Patch
					1 1/2 hrs. Town Shovel @6.50
					1 hr. Town Truck
					3.00
					117.75

Bill sent 11964

TOWN OF LEXINGTON — BOARD OF PUBLIC WORKS
WATER DIVISION

Sketch of Service Here

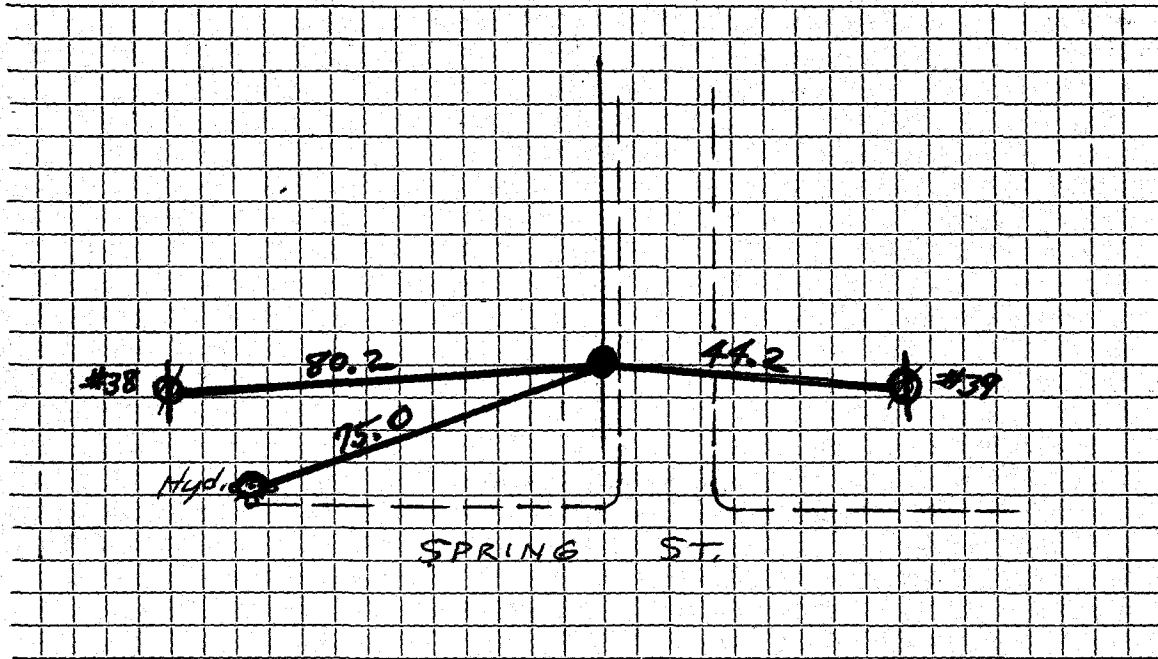

Connection made in Street. Work completed

Remarks:

.....

.....