


DATE APRIL 16, 1997

TOWN OF LEXINGTON — BOARD OF PUBLIC WORKS

WATER DIVISION

Sketch of Service Here

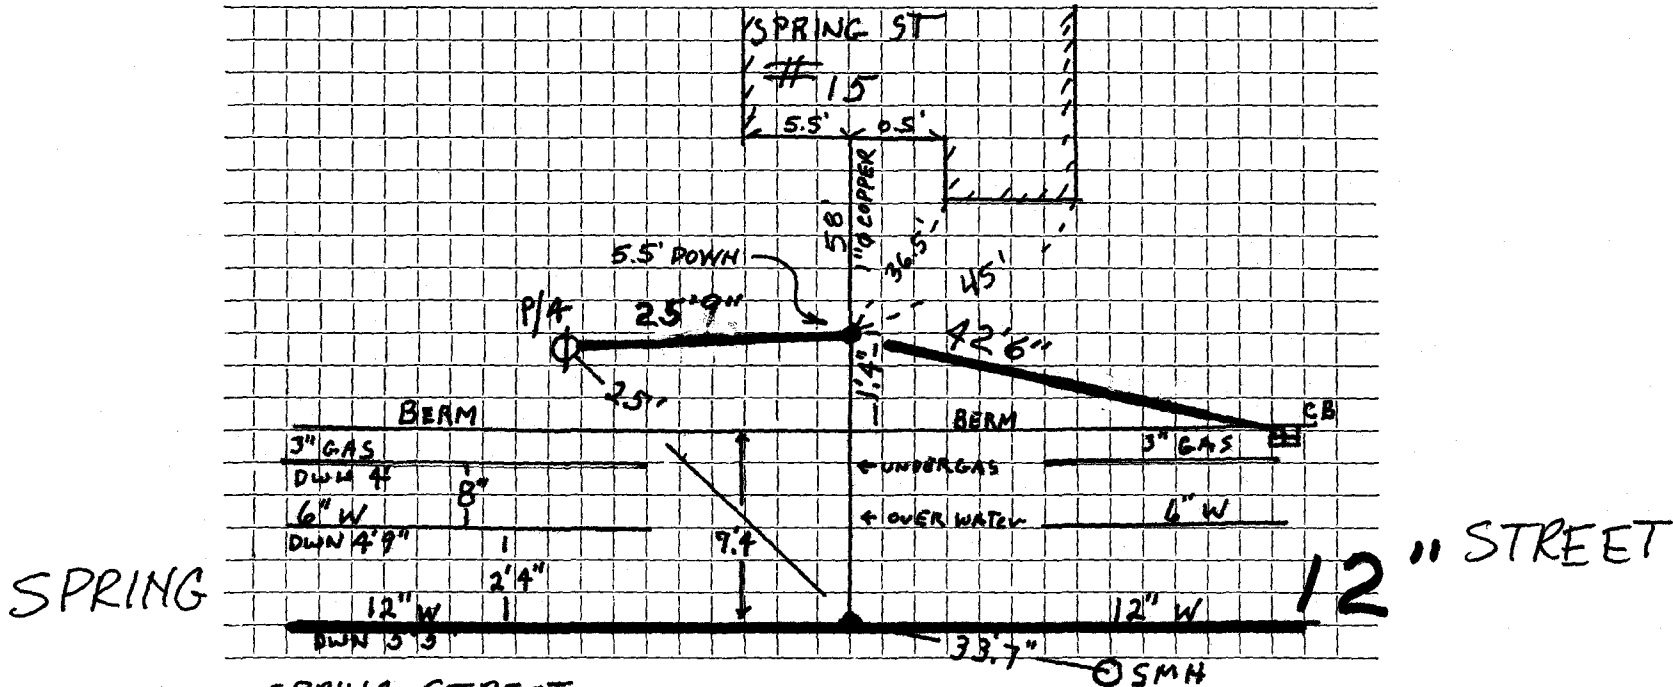

Connection made in SPRING STREET Street. Work completed

Remarks:

BOOK # 97-1