




TOWN OF LEXINGTON — BOARD OF PUBLIC WORKS

**WATER DIVISION**

Sketch of Service Here

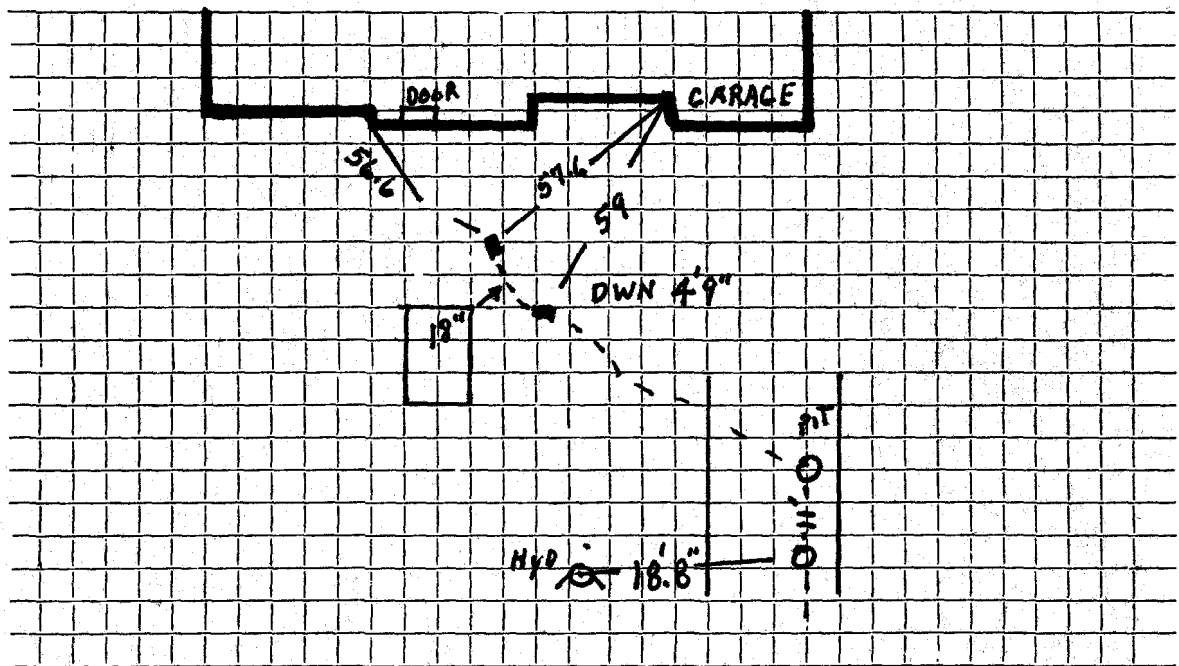

Connection made in ..... Street. Work completed .....

Remarks: 5'-1" COPPER BETWEEN UNIONS.  
 5-23-95: Eliminated Pit ..... 1-3 part union on each side of old Pit  
 1ST one is 9' From Curb Installed 7'-1" Copper