

WATER SERVICE RECORD

Name

Service No.

Address 16 SPRING ST

Location

Repair—Renewal—New Service

Ties & Info
copper

NO INFO IN
Tim's Field book

Date	Material	Amount
June 48	30' 3/4 Copper	
	3/4 x 1/2 S & W	

Dec
1" C
1" Cur
1" Curb STOP
1 3/4 Red.
buffle box

mount


DATE _____

TOWN OF LEXINGTON — BOARD OF PUBLIC WORKS

WATER DIVISION

Sketch of Service Here

SPRING ST

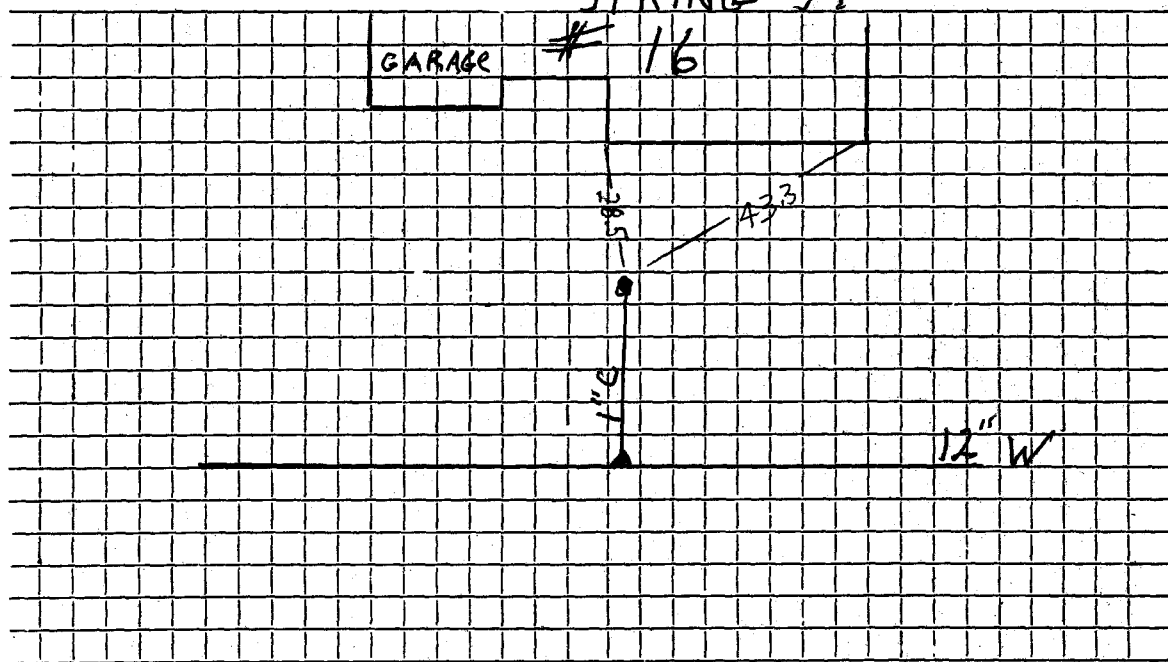

Connection made in Street. Work completed 2002

Remarks: 2003. T's's. MAY. have changed. No. IN. G. Tim. book.

WATER SERVICE RECORD

Name

Service No.

Address 16 SPRING ST

Location

Repair—Renewal—New Service

Date	Material	Amount	Total	Date	Dem.	Amount
June 48	30' 3/4 Copper 3/4 x 1/2 S & W			July 02	Dem. 1" Copper 1" Corp 1" Curb & Top 1 3/4 Red. buff lo box	

Tie & info
copper

NO INFO IN
Times Field book


DATE _____

TOWN OF LEXINGTON — BOARD OF PUBLIC WORKS

WATER DIVISION

Sketch of Service Here

SPRING ST

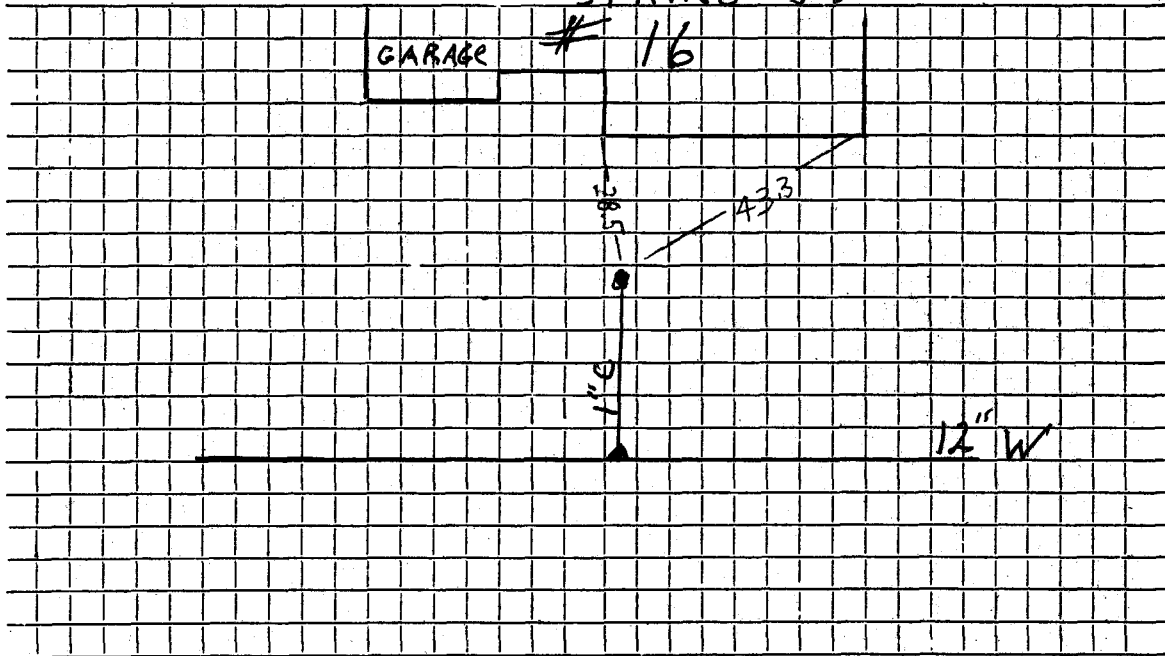

Connection made in Street. Work completed 2002

Remarks: 2003. T's's. MAY have changed. No INFO. Tim's book.