

WATER SERVICE RECORD

Name William H. Hamilton

Service No. 376

Address 163 Spring Street

Location 163 Spring ST.

~~Repair-Renewal~~ - New Service


Committed 4-2-56

Date	Material	Amount	Total	Date	Amount
1/17/56	Labor	1 85		11-22-55	Deposited \$ 150 00
	10% overhead	19	2 04	4-2-56	Refunded 34 44
	195' - 3/4" Copper tubing @ .50	97 50			NON CHARGE 115 56
	3 - 3/4 C Unions (3 part) @ 1.77	5 31		12/17/55	Labor 31 04
	1 - 3/4 C x 1/2 I.W.H. Stop & Waste	4 96		20' - 3/4" Copper tubing @ .50	10 00
	1 hr. trucking @		75	1 - 3/4 C. Corp Cock	4 34
	5x3 patching		5 00	1 - 3/4 C. Curb Cock	5 94
			115 56	1 Box & rod	4 62
				1 - 1/2 Straight tailpiece	50
				1 - 1/2 Offset tailpiece	50
				4 2/3 hrs. Littlefield Shovel @ 8.50	39 66
				1 hr. trucking	75
					97 35

TOWN OF LEXINGTON — BOARD OF PUBLIC WORKS

WATER DIVISION

Sketch of Service Here
SPRING ST 163

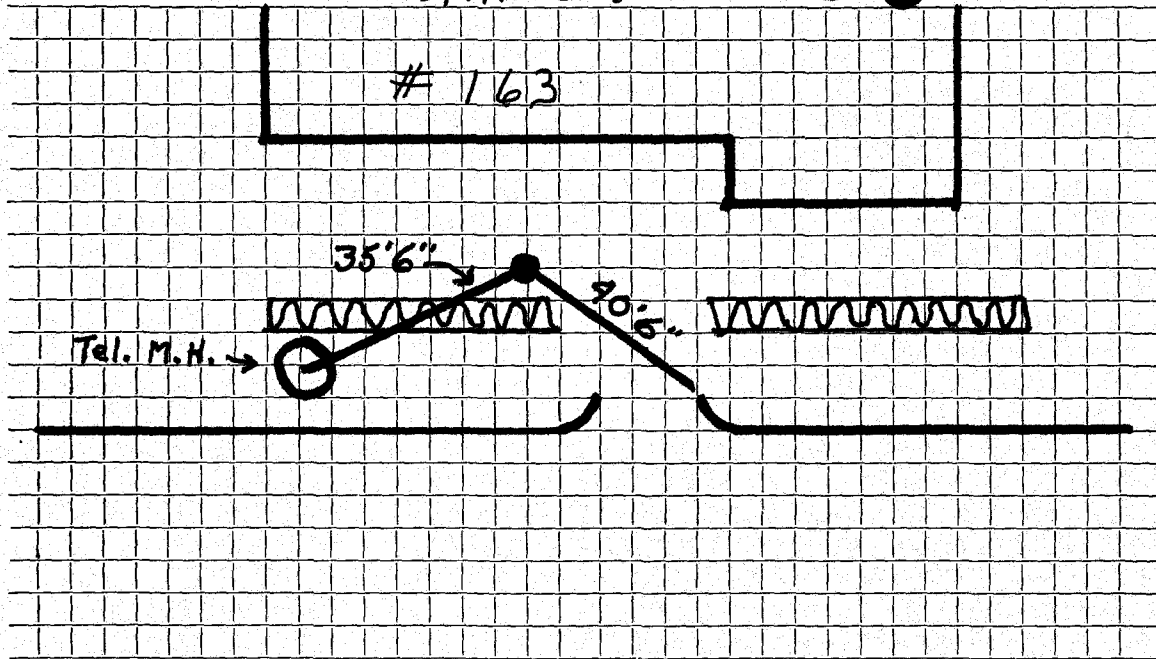

Connection made in Street. Work completed

Remarks:
.....
.....