

WATER SERVICE RECORD

Name Robert H. George

Service No 204

Address 164 Spring Street

(1951)

Location Lexington

Repair—Renewal—New Service

Com. 7-28-52


Date	Material	Amount	Total	Date	Amount
6/30/52	Labor	6 32		6-25-51 Deposited	25 00
	10% Overhead	63	6 95	7-28-52 Refunded	(20 95)
	65' -3/4" Copper tubing @.3439	22 35			<u>NON CHARGE</u>
	1 - 3/4" C. X 1/2 I.W.H. Stop & Waste	4 00		6/30/52 Labor	6 32
	4 hrs. Town Shovel @5.00	20 00		28' - 3/4" Copper tubing @.3439	9 62
	1 hr. trucking		75	1 - 3/4" C. Corp. Cock	4 33
			54 05	1 - 3/4" C x 3/4 C. Curb-cock	4 67
				1 Box and Rod	4 52
				1 - 1/2 straight tail piece	50
				1 - 1/2 offset tail piece	50
				2 hrs. Town Shovel @5.00	10 00
				1 hr. trucking	75
					<u>41 21</u>

DATE _____

TOWN OF LEXINGTON — BOARD OF PUBLIC WORKS

WATER DIVISION

Sketch of Service Here

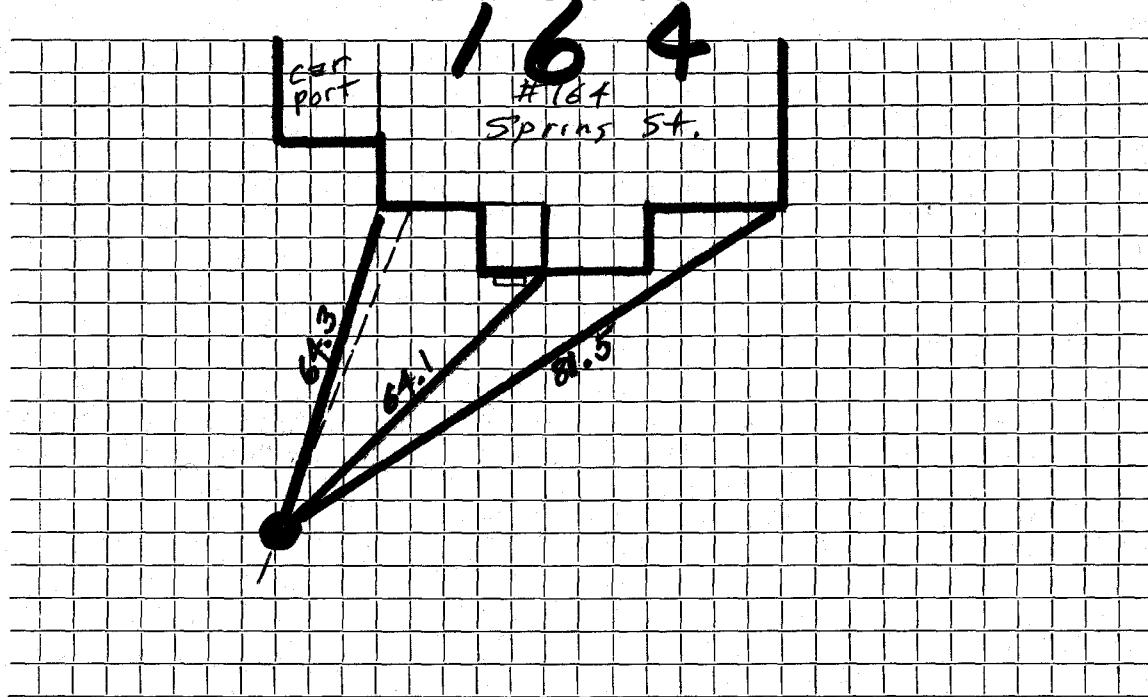

Connection made in Street. Work completed

Remarks: ON 8" MAIN

.....
.....