

WATER SERVICE RECORD

#270

Name William H. Hamilton

Service No. 375

Address 165 Spring Street

Location

~~Repair - Transit~~ New Service

Committed 4-2-56


Date	Material	Amount	Total	Date	Amount
1/12/56	Labor	1 85		11-22-55	Deposit \$ 150 00
	10% overhead	19	2 04	4-2-56	Refunded 48 71
	180' - 3/4" Copper tubing @ .50		90 00		NON CHARGE 101 29
	2 - 3/4" C Unions (3 part) @ 1.77		3 54	1/12/56	Labor 23 57
	1 - 3/4" C x 1/2" I.W.H. Stop & Waste		4 96	14' - 3/4" Copper tubing @ .50	7 00
	1 hr. trucking		75	4 2/3 hrs. Littlefield Shovel @ 8.50	39 66
			101 29	1 hr. trucking	75
				1 - 3/4" C. Corp Cock	4 34
				1 - 3/4" C. Curb Cock	5 94
				1 Box & rod	4 62
				1 - 1/2" straight tailpiece	50
				1 - 1/2" offset tailpiece	50
					101 29

DATE _____

TOWN OF LEXINGTON — BOARD OF PUBLIC WORKS

WATER DIVISION

Sketch of Service Here

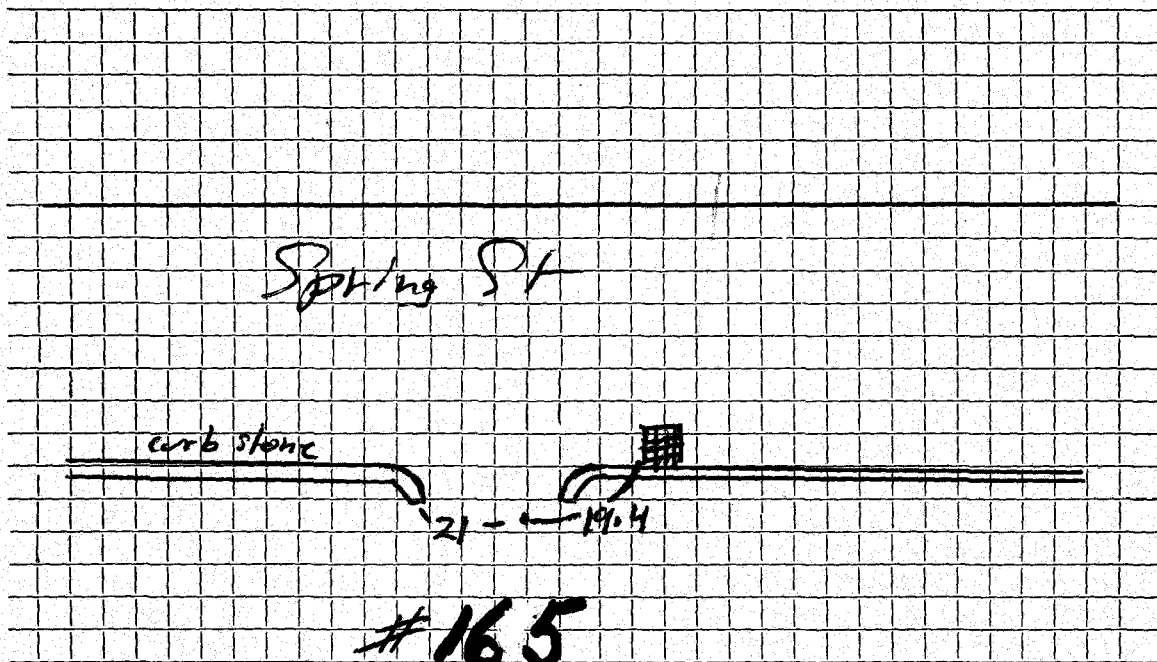

Connection made in Street. Work completed

Remarks:

.....

.....