

#5799

## WATER SERVICE RECORD

Name Lawrence J. Harrington

Service No. 137

Address 166 Spring Street

Location (4 Arlington St., Cambridge, Mass.)

EX-1000-A-1000—New Service

Comm 12-4-61

Date	Material	Amount	Total	Date		Amount
10/7/61	Labor	79 49		9-22-61	Deposit	200 00
	10% O.H.	7 95	87 44	12-26-61	Paid	35
	10' 3/4" Copper Tubing @ .42	42 42				200 35
	1 3/4" C x $\frac{1}{2}$ IWH Stop & Waste	6 17	10/13/61	Labor		37 00
	2 3/4" C3 part Unions @ 2.41	4 82			Curb to Main	
	34 X 3 Patch	34 00	47' 3/4" Copper Tubing @ .42			19 74
3	Hrs. Town Shovel @ 6.50	19 50	1 3/4" C Corp Cock			4 91
2	Hrs. Trucking @ 3.00	6 00	1 3/4" C Curb Cock			6 28
		200 35	1 Bow & Rod			4 90
			1 $\frac{1}{2}$ Straight Tailpiece @ .50			50
			1 $\frac{1}{2}$ Offset Tailpiece			50
						73 83


10/16/97 4' 3/4 COPPER  
2 3/4 CxP UNIONS

B/H sent - .35

DATE \_\_\_\_\_

TOWN OF LEXINGTON — BOARD OF PUBLIC WORKS  
WATER DIVISION

Sketch of Service Here

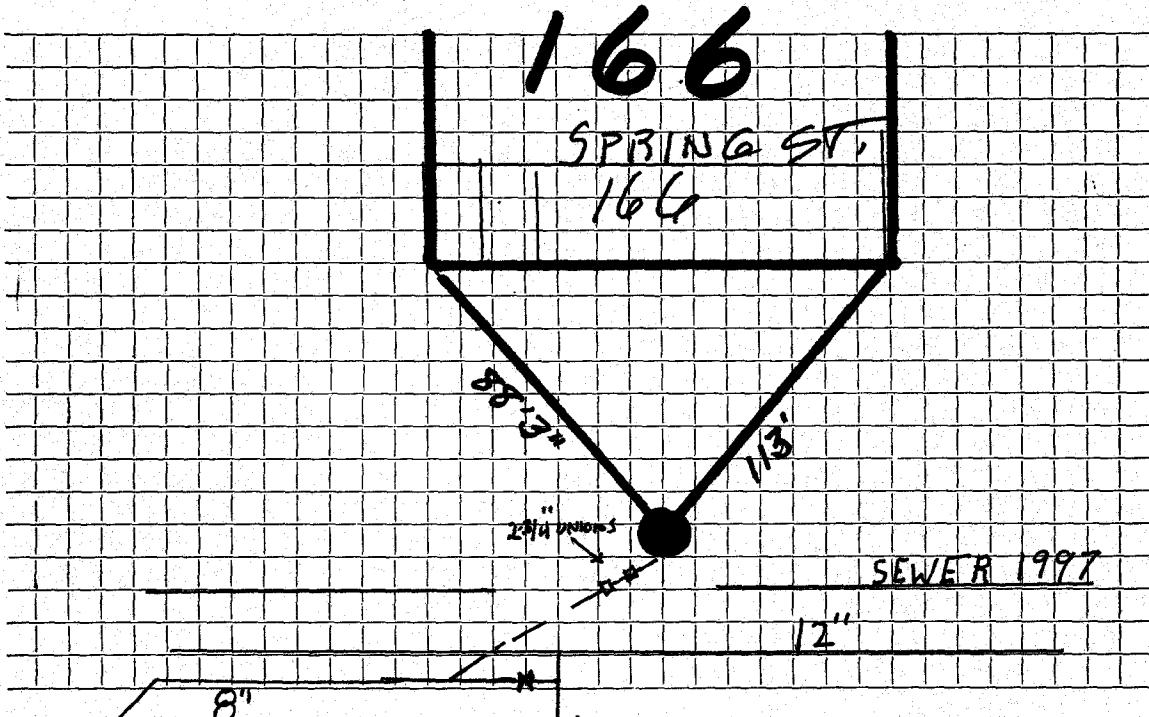

3 $\frac{1}{4}$ " copper  
101' in  
47 out.

Connection made in ..... Street.  Work completed .....

Remarks: SERVICE ON 8" MAIN.....

10/97 4-3/4 COPPER 2-3/4 UNIONS HOUSE SIDE OF SEWER.....