

WATER SERVICE RECORD

Name Deck House Inc.

Service No. 42

Address

180 Spring St

Location

Repair—Renewal—New Service

Lucente #3148

W.O.#1245

APR 8 1974


Date	Material	Amount	Total	Date	Amount
10/12/73	240' 1" Copper tubing			9-4-73	435.00
				4-8-74	5.49
9/7/73	Labor	194.53			419.31
	10% O.H.	19.45	\$213.98		
	35' 3/4" Copper @ .60		21.00		
	1 3/4" Corporation		7.42		
	1 3/4" Curb cock		11.32		
	1 Box & rod		7.34		
	1/2 ton Cold Patch		8.25		
	Street Patch 36' x 4'		96.00		
	1 hr. Roller		2.00		
	4 hrs. Trucking @ 3.00		12.00		
	3 hrs. Town Shovel @ 6.50		19.50		
	3 hrs. Compressor @ 5.00		15.00		
	1 hr. Loader		4.00		
	1 hr. Pickup		1.50		
			<u>\$419.31</u>		

DATE _____

TOWN OF LEXINGTON — BOARD OF PUBLIC WORKS

WATER DIVISION

Sketch of Service Here

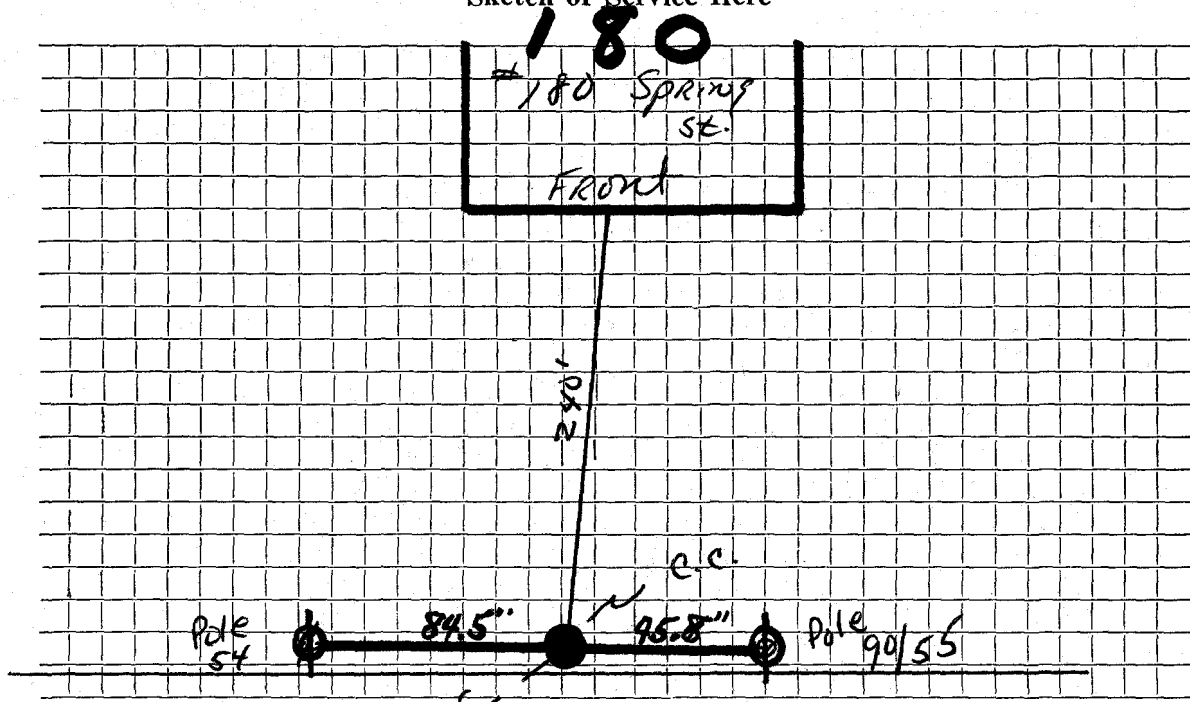

Connection made in Street. Work completed

Remarks:

.....
.....