

WATER SERVICE RECORD

Name

Service No.

Address 186 SPRING ST

Location

Repair—Renewal—New Service J. McLaughlin

Date	IN	Material	Amount	Total	Date	Material	Amount
5/20/02	190'	1.5 COPPER			5/20/02	8" 1.5 Service saddle	
		VALVE				1.5 CORP.	
	3	1.5 UNION'S				1.5 Curb STOP	
						Bufflo box	
					34'	1.5 COPPER	


DATE _____

TOWN OF LEXINGTON — BOARD OF PUBLIC WORKS

WATER DIVISION

#186

Sketch of Service Here

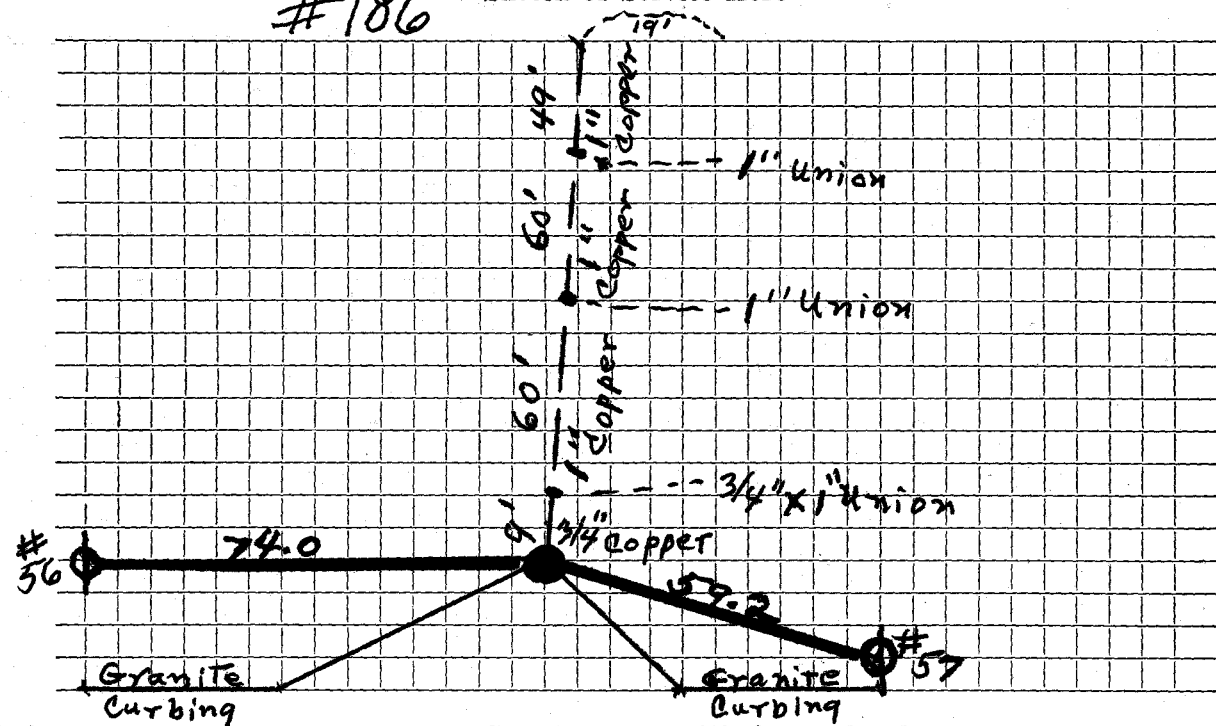

Connection made in Street. Work completed

Remarks:
.....
.....