

WATER SERVICE RECORD

Name Com'lthwealth Therapeutic Day School

Service No. _____

Address 189 Spring ST

Location _____

Repair—Renewal—New Service


Date		Material	Amount		Total		Date		Amount	
9/03/93	85"	1" Copper								
	1	3 pt. 1" Copper Coupling								
								OUTSIDE		
							9/03/93 19'	1" Copper		
								1" Curb Stop open left		
								1 Buffalo Box		

DATE 9-3-93

TOWN OF LEXINGTON — BOARD OF PUBLIC WORKS

WATER DIVISION

Sketch of Service Here

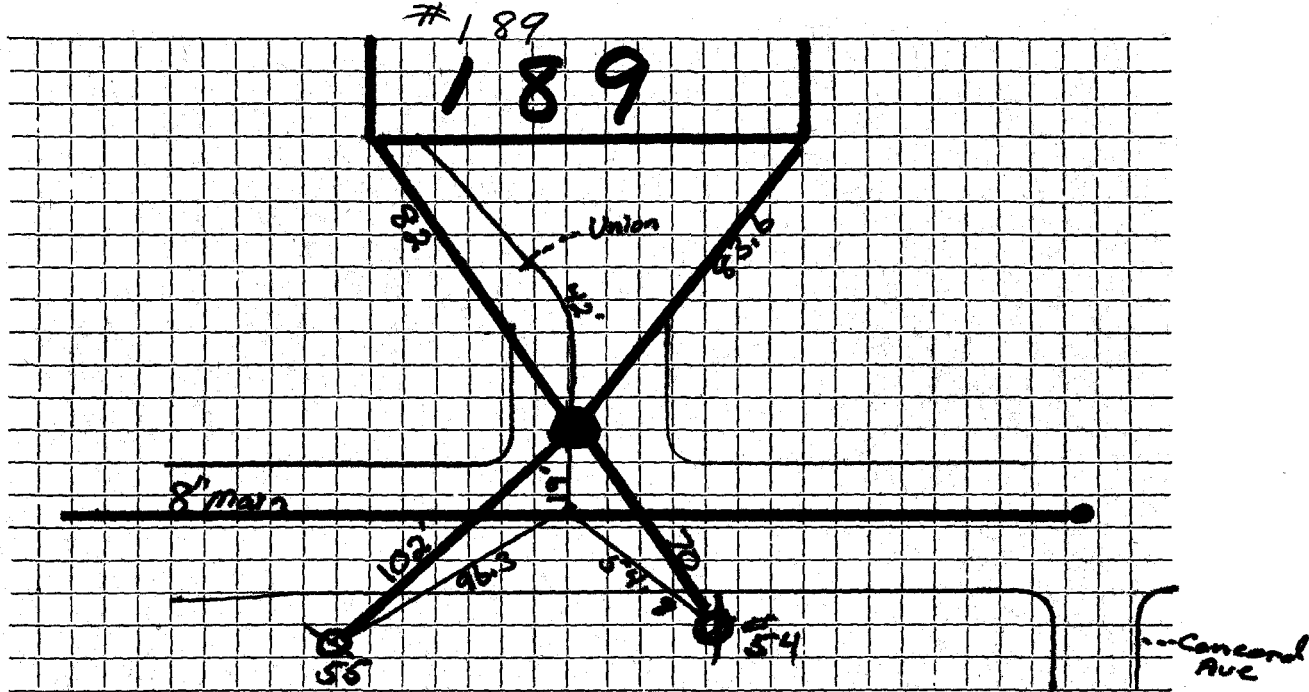

Connection made in ... 9-2-93 Street. Work completed

Remarks: Telephone Duct Line 3' out of Curb in Sidewalk