

## WATER SERVICE RECORD

Name Ginn &amp; Co. Attn: Mr. Owens

Service No. 37

Address 191 Spring Street

Location

~~Repair-Renewal~~—New Service W.O. #3460.

NOV 24 1976

Date	Material	Amount	Total	Date	Amount
6-16-75	Labor	174.76		6-30-75	800.00
6-19-75	"	78.60		7-24-75	150.00
6-20-75	"	24.66			649.96
6-24-75	"	15.06	293.08		
	10% O.H.	29.31	\$322.39		
37'	2" Copper Pipe	@3.35	123.95		
1	3/4" x 1/2" Brass Bushing		1.46		
1	2" x 3/4" Reducing Coupling		2.60		
1	2" C.L.N.		.94		
2	2" Brass Flanges	@8.00	16.00		
1	Pit Meter Frame & Cover		42.00		
1/2	Bag Cement	@2.20	1.10		
36	Red Bricks	@.23	8.28		(CONT.)
48	Barrel Blocks	@.48	23.04	3	Hrs. Trucking @3.00 9.00
1	Ton Cold Patch		12.20	4	Hrs. Pick up @1.50 6.00
1	Patch 12' x 6'		48.00	2	Hrs. Backhoe @6.50 13.00
1	Patch 12' x 5'		40.00		669.96
	(CONT.)				

DATE \_\_\_\_\_

**TOWN OF LEXINGTON — BOARD OF PUBLIC WORKS**

**WATER DIVISION**

Sketch of Service Here

A large grid of graph paper, consisting of 20 columns and 20 rows of small squares, intended for sketching service details.

Connection made in ..... Street.                      Work completed .....

Remarks: .....  
.....  
.....




TOWN OF LEXINGTON — BOARD OF PUBLIC WORKS

WATER DIVISION

Sketch of Service Here

water shut off  
for both lawn  
accounts they will  
be fed from  
a well

10/3/55

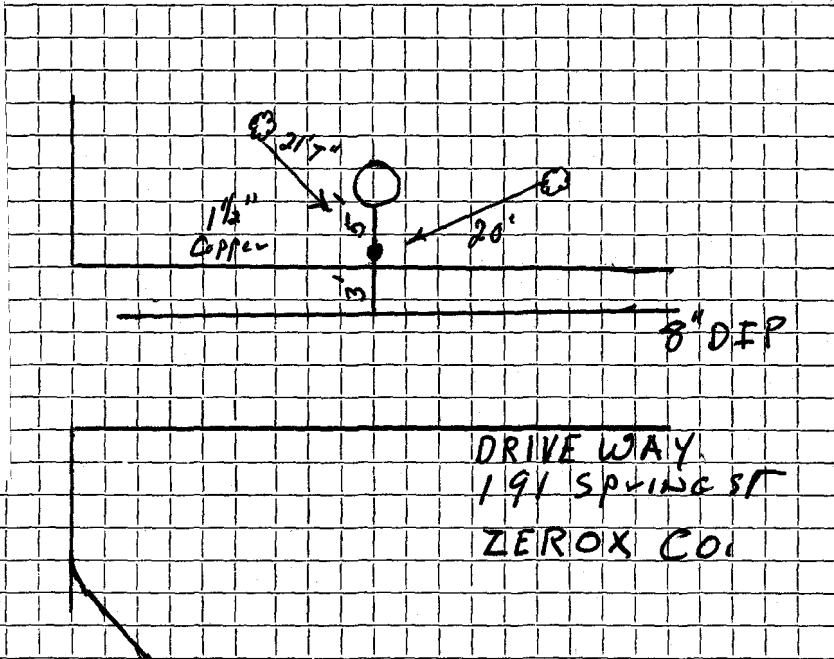

DRIVE WAY  
191 SPRING ST  
ZEROX CO

Connection made in ..... Street. Work completed .....

Remarks: .....

