


DATE 10.5.93

TOWN OF LEXINGTON — BOARD OF PUBLIC WORKS
WATER DIVISION

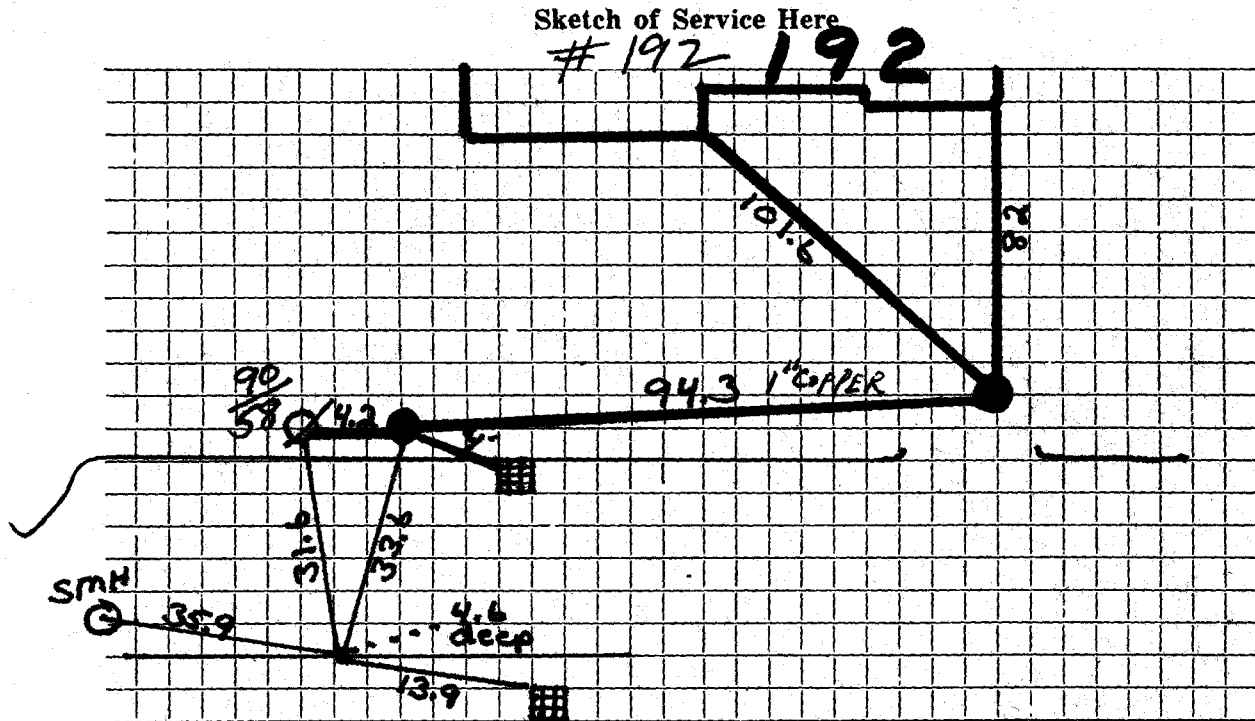

Connection made in Street. Work completed 10.4.93

Remarks: There are two Curb Boxes one by the Pole the other in the driveway. Iron Pipe inside.
94.3 From Curb to Curb in front of house.