

Name **Roby Rogers**Service No. **91**Address **23 Spring Street**

#4996

Location **23 Spring Street**

Kind of Pipe

Size

Size of Main **ON 12" MAIN**Requirements **Renewal - New Service**Com. **8-15-49**

Location

Date	Material	Amount	Total	Date	Amount
June 8, '49	Labor	2 00	2 00	May 31, '49	40 00
June 9, '49	Labor	1 25	1 25	May 25, '49	5 00
	10% Overhead		33		34 46
	41' - 3/4" Copper Tubing @.24	9 84	9 84	June 9, '49	9 88
	1 - 3/4" C x 1/2" I.W.H. S&W	3 29	3 29	7' - 3/4" Copper Tubing @.24	1 68
	Littlefield Shovel 2 hrs. @7.00	14 00	14 00	1 - 3/4" C Corp-cock	3 15
	Trucking 1 hr. @.75		75	1 - 3/4" C x 3/4" C Curb-cock	3 85
	Patching 3 x 3		3 00	1 - Box & Rod	3 95
			34 46	1 - 1/2" Offset Tail Piece	37
				1 - 1/2" Straight Tail Piece	37
				Littlefield Shovel 2 hrs.	14 00
				Trucking 1 hr. @.75	75
	Labor				38 00

DATE \_\_\_\_\_

TOWN OF LEXINGTON - BOARD OF PUBLIC WORKS

**WATER DIVISION**

The undersigned applies for a supply of water at No..... St. and hereby agrees to comply with the rules and regulations as now, or at any future time, established by the Board of Selectmen.

Am't of Estimate \$.....

Owner .....


Am't Paid \$.....

Address .....

Builder .....

.....

Sketch of Service Here

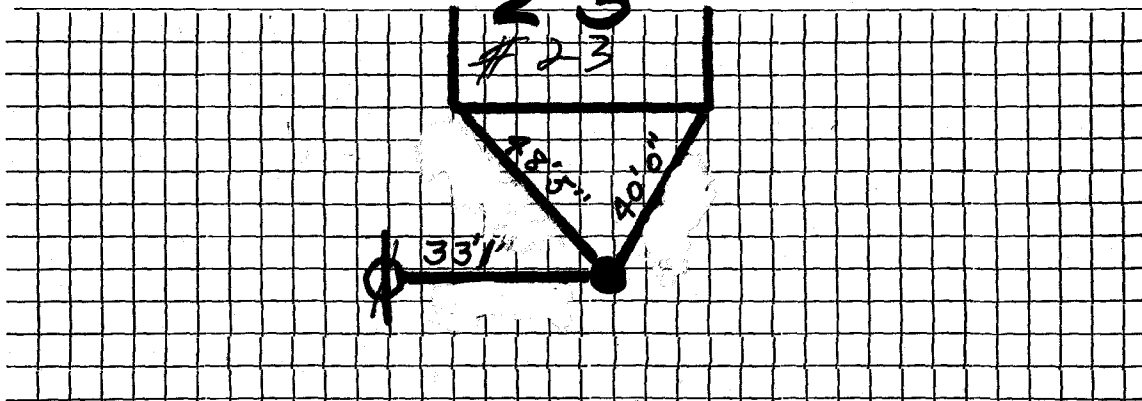

Connection made in ..... Street.

Work completed .....19

Remarks: