

**WATER SERVICE RECORD**

Name \_\_\_\_\_

**Service No.**

**Address** 24 SPRING ST

### **Location**

## **Repair—Renewal—New Service**


DATE \_\_\_\_\_

TOWN OF LEXINGTON — BOARD OF PUBLIC WORKS

WATER DIVISION

Sketch of Service Here

SPRING ST

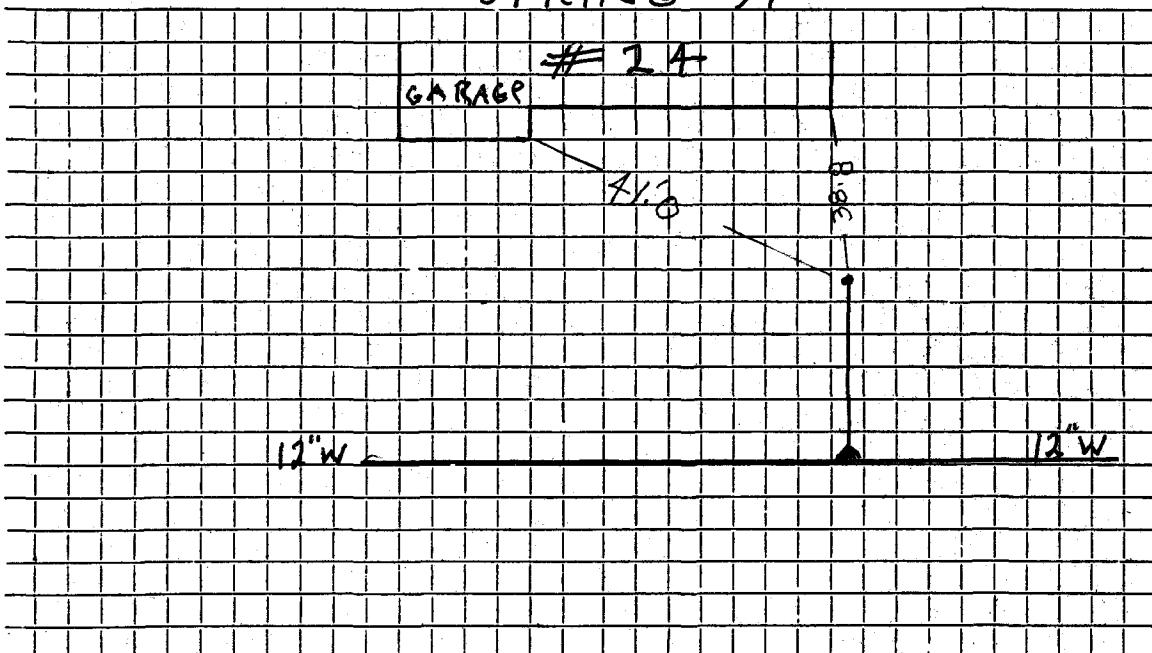

Connection made in ..... Street. Work completed 2.00<sup>2</sup>. Dec. 1.....

Remarks: No info on tie-in, knobs, & ties.