

WATER SERVICE RECORD

Name *Mr. Stacey*

Service No.

Address *27 Spring Street*

Location

~~Repair—Renewal—New Service~~ W.O.#1350. (outside)~~on 6" main~~


Date	Material	Amount	Total	Date	Deml	Amount
9-4-73	Labor		\$50.70	July 02	1" Copper	
	8' 3/4" Copper @160		4.80		1" CorP	
	1 3/4 Corporation Adapter				1" Curb	
	3 3/4 Curb Cork		11.32		1x 3/4 Red	
	1" Repair Clamp				bufflo box	
	1" x 3" C.L. Nipple					
	Box & Rod		7.34			
	1 Hr. Town Shovel					
	Renewal Kirkland & Shaw #3905					
10/19/84	41' 3/4" Copper tubing					

DATE _____

TOWN OF LEXINGTON — BOARD OF PUBLIC WORKS

WATER DIVISION

Sketch of Service Here

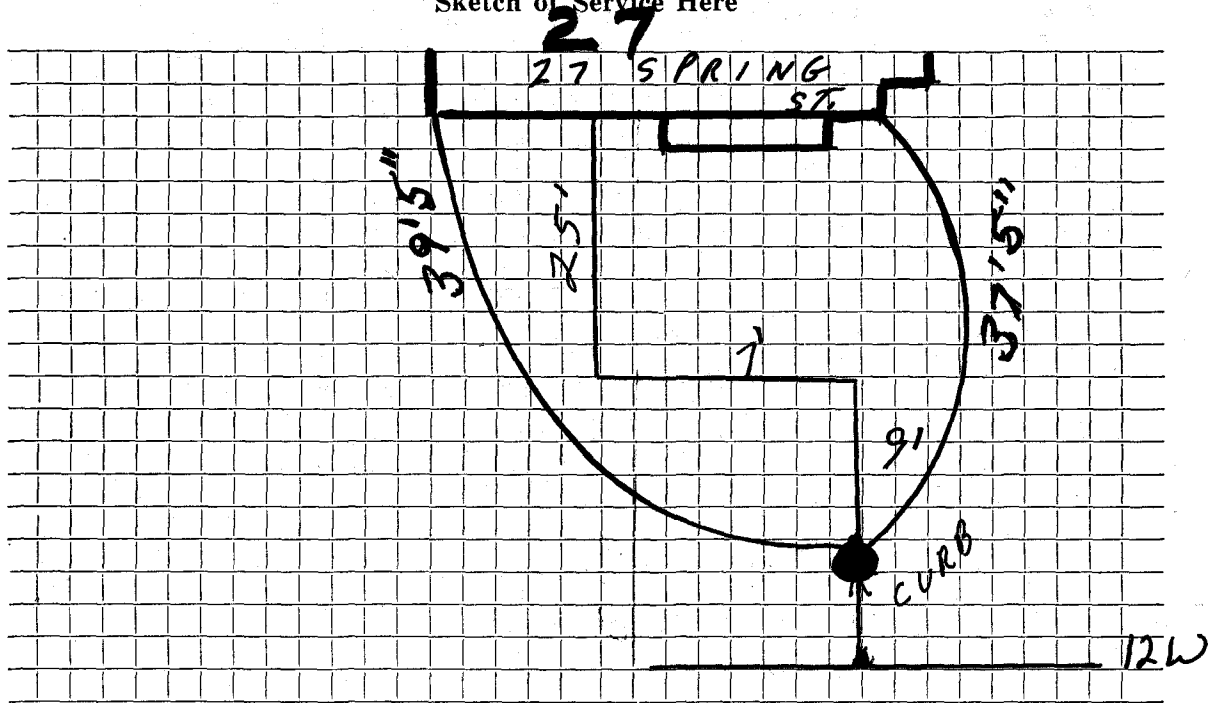

Connection made in Street. Work completed .. 2002

Remarks: No. INFO. IN THIS book.