


DATE _____

TOWN OF LEXINGTON — BOARD OF PUBLIC WORKS

WATER DIVISION

Sketch of Service Here
SPRING ST

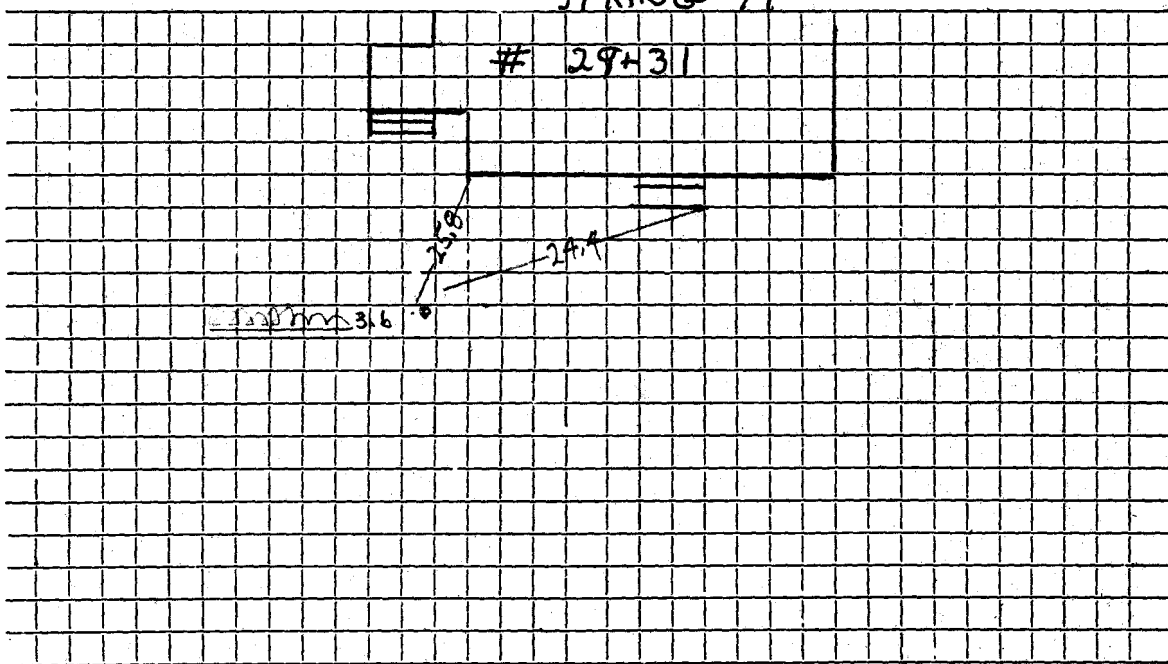

Connection made in Street. Work completed

Remarks: 2002-Ties may have changed

.....
.....