

WATER SERVICE RECORD

Name Timothy Hart

Service No. 43

Address 30 Spring Street

Location

~~Repair~~ Renewal ~~New Service~~

W.O. #1249

Charged ~~120.00~~ ~~paid~~

APR

8 1974


Date	Material	Amount	Total	Date	Amount
9/10/73	Labor	33.40		9-10-73	150.00
	10% O.H.	3.34	\$36.74	4-8-74	72.06
	32' 3/4" Copper pipe @ .60		19.20		77.94
	1 3/4" Wheel valve		12.01	9-11-73	
	1 Ground clamp		.49		
	1 hr. Trucking		3.00		
	1 hr. Town Shovel		6.50		
			\$77.94	July 02	
					25' 3/4" Copper
					1 3/4" C. Corp Cock
					1 3/4" C. Curb Cock
					1" Copper
					1" Corp
					1" Curb
					1 x 3/4 Red.
					buff lo box

DATE _____

TOWN OF LEXINGTON — BOARD OF PUBLIC WORKS

WATER DIVISION

Sketch of Service Here

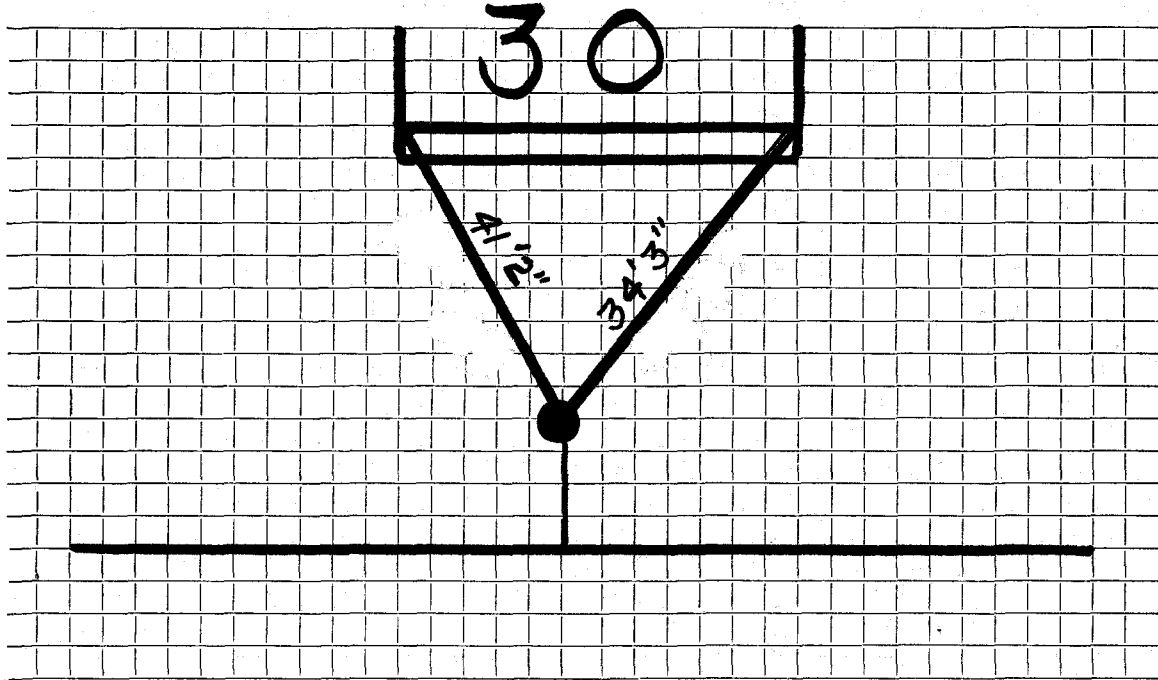

Connection made in Street. Work completed .. 2007 Dec 1st

Remarks: NO info in Times book

.....
.....