

Name *Virgil Hathaway* WATER SERVICE RECORD
 Robert Ericson

Service No. 190

Address 34 Spring Street

Location

~~Repair - Renewal~~ New Service~~ORC~~ Comm 12-31-61


Date	Material	Amount	Total	Date	Amount
12/13/61	Labor	2 04		12-30-61	50 00
	10% O.H.	20	2 24	12-31-61	25 31
	39' 3/4" Copper Tubing @ .42		16 38		24 79
	1 3/4" Cx 1/2 IWH Stop & Waste		6 17		
	Extention - Arlex #4986		24 79		
8/12/87	54' 3/4" Copper tubing			12/13/61	2 00
				26' 3/4" Copper Tubing @ .42	10 92
				1 3/4" C Curb Cock	6 28
				1 3/4" C Corp Cock	4 91
				1 Box & Rod	4 90
				1 1/2 Straight Tailpiece	50
				1 1/2 Offset Tailpiece	50
				July 02	30 01
				1" Copper	
				1" Corp	
				1" Curb	
				1x 3/4 Red	
				buffle box	

DATE _____

TOWN OF LEXINGTON — BOARD OF PUBLIC WORKS

WATER DIVISION

Sketch of Service Here

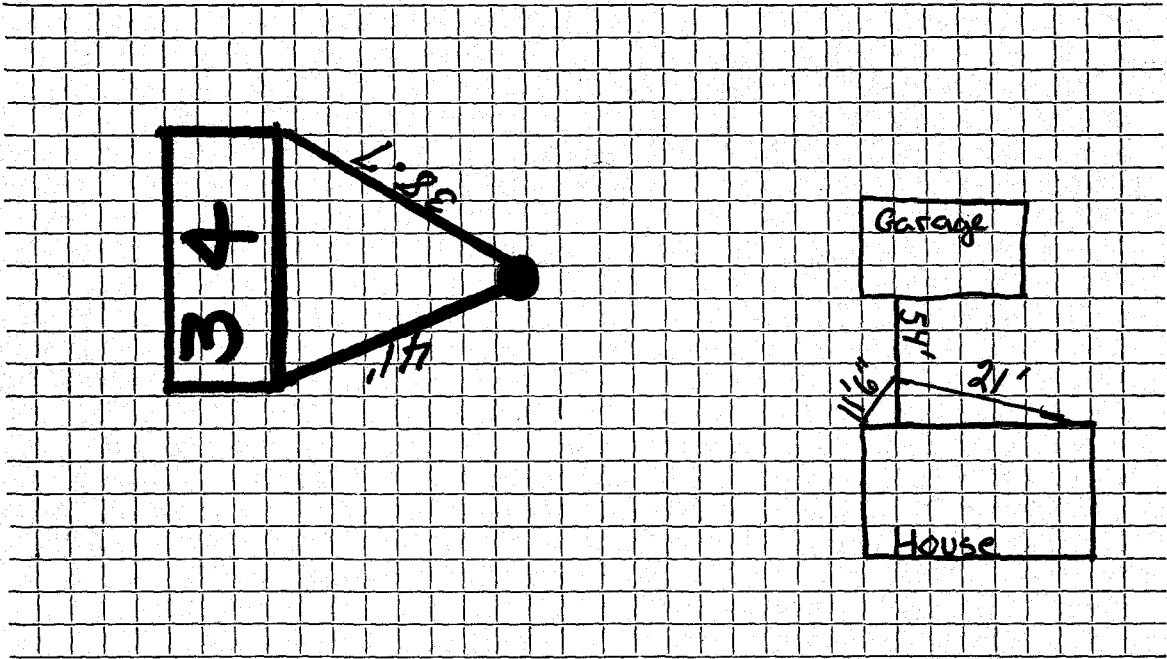

Connection made in Street. Work completed . 2002

Remarks: NO INFO IN TINS BOOKS. TINS MAY HAVE BEEN REPAIRED


.....

DATE _____

TOWN OF LEXINGTON — BOARD OF PUBLIC WORKS

WATER DIVISION

Sketch of Service Here

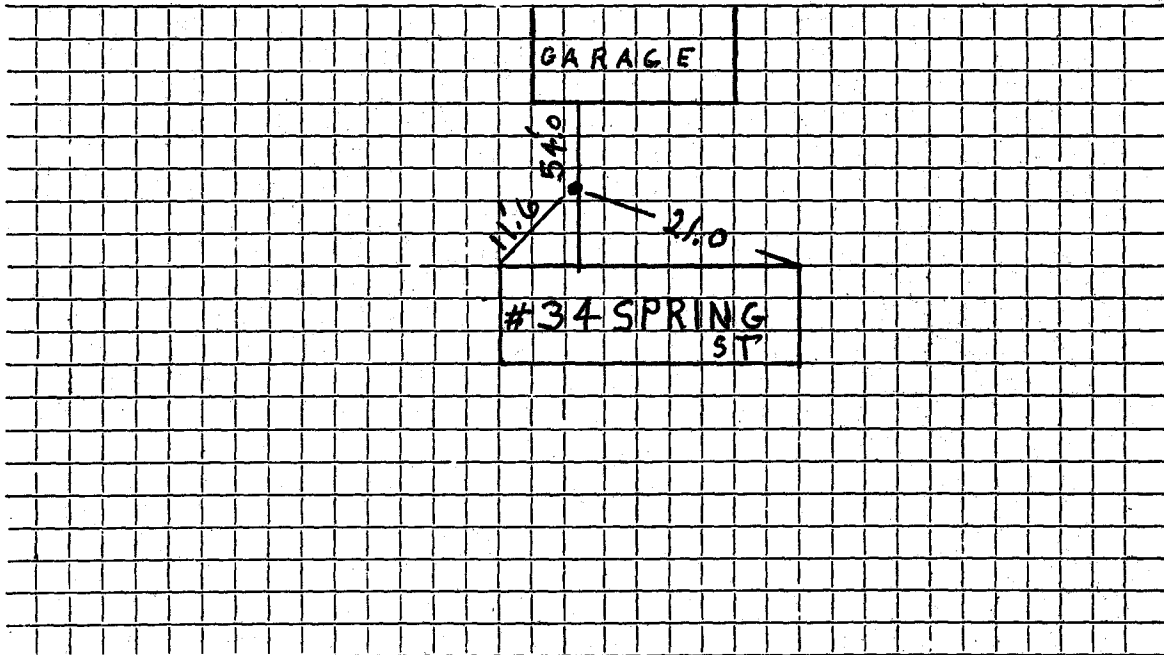

Connection made in Street. Work completed

Remarks:
.....
.....