

WATER SERVICE RECORD

Name Annelie Products Co.

Service No. 50

Address 35-37 Spring Street

Location

~~Repair~~—Renewal—~~New Service~~

W.O. #1339

ON 12" ~~ONE~~ " MAIN APR

8 1974


Date		Material	Amount	Total	Date	Amount
7/27/73		Labor	69.15		9-26-73	150.00
		10% O.H.	6.92	76.07	4-8-74	12.85
	35'	1" Copper @ .77/ft		26.95		137.12
	1	1" Wheel valve		12.01	July 02	1" Copper
	1	Ground clamp		.49		1" Corp
	1	3/4" Coupling		2.60		1" Curb
	2	hrs. Trucking @ 3.00		6.00		1" buffalo box
	2	hrs. Town Shovel @ 6.50		13.00		
				\$137.12		

DATE _____

TOWN OF LEXINGTON — BOARD OF PUBLIC WORKS

WATER DIVISION

Sketch of Service Here

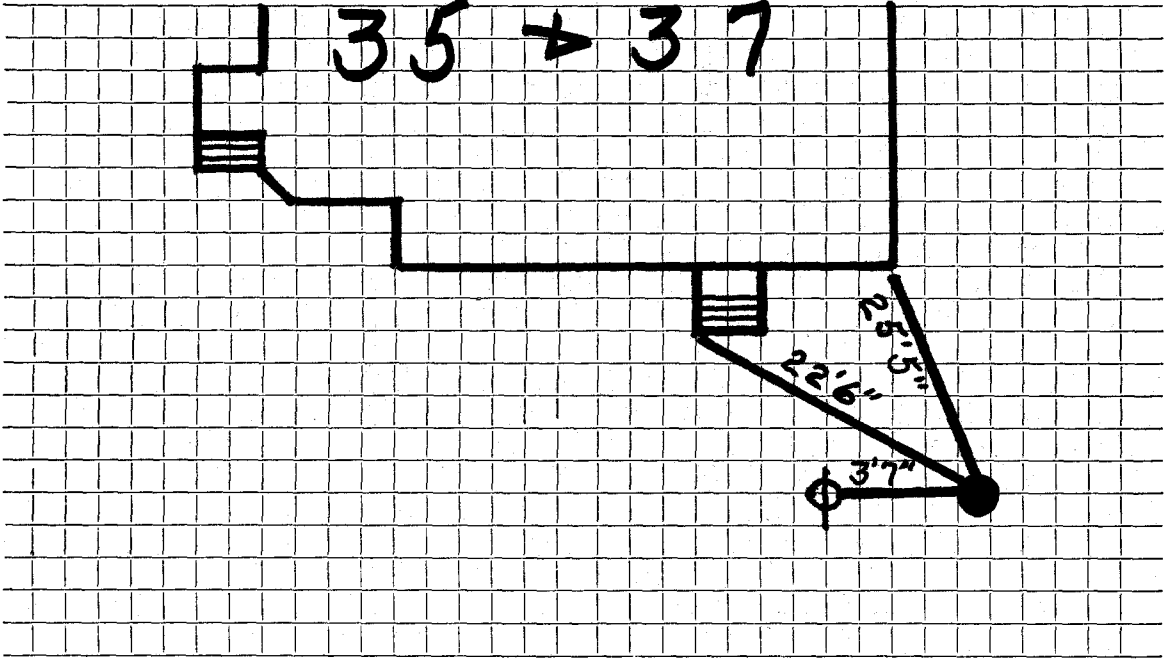

Connection made in Street. Work completed

Remarks:
.....
.....