

## WATER SERVICE RECORD

Name **L.H.Hewett Jr., Inc.**

Service No. **39**

Address **39 Spring Street**

Location

~~Repair - Damage~~ - New Service W.O.#850 Hewett 3492

**ON 12" MAIN JUL 7 1980**

Date	Material	Amount	Total	Date		Amount
12-11-79	Labor	53.36		10-31-79	Deposit Paid by W.H.# 43	120.00
	10% O.H.	5.34	58.70	7-7-80		41.04
12'	3/4" Copper tubing @.94		11.28			161.04
1	3/4" Corp		12.40			
1	3/4" Curb		17.73			
1	Box & Rod		10.95			
	Hot Top 15' x 5'		149.98			
			161.04			
1-2-80	111' 3/4" Copper tubing					
					Bill sent 4/1/84	


✓

DATE \_\_\_\_\_

TOWN OF LEXINGTON — BOARD OF PUBLIC WORKS

WATER DIVISION

Sketch of Service Here

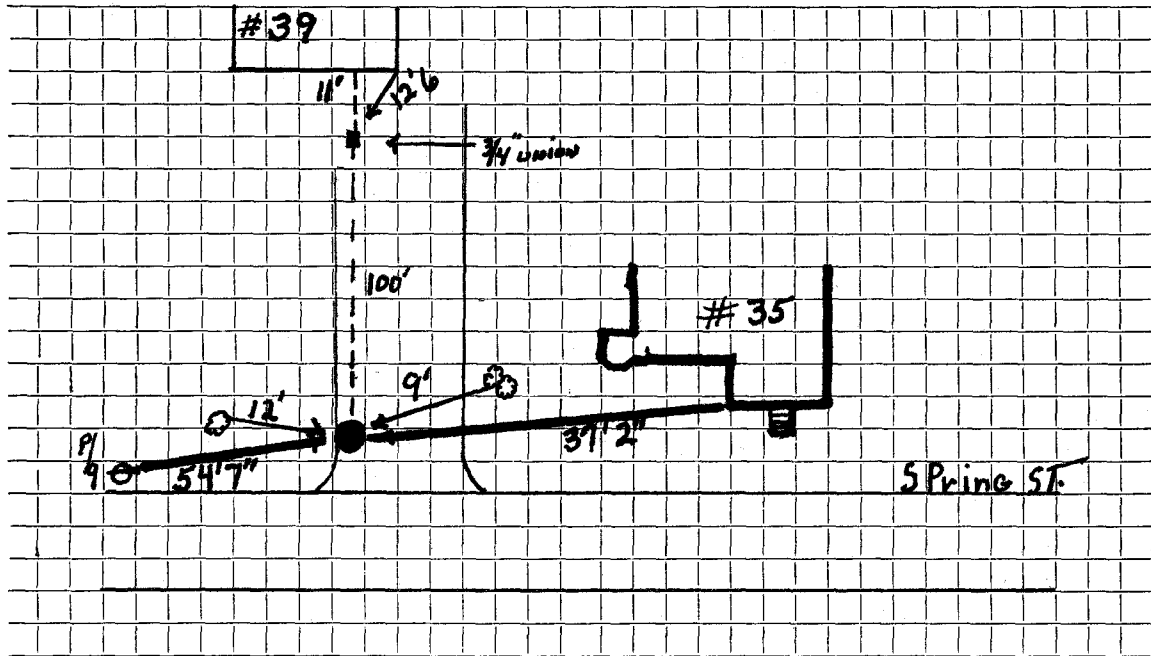

Connection made in ..... Street. Work completed .....

Remarks: .....

.....

.....