

Name Gelfrido MarcelliService No. 20Address 41 Spring Street# 3414# 6972

Lexington, Mass.

Location 41 Spring Street

Kind of Pipe

Size

Size of Main 12" ~~12" main~~~~XXXXXXXXXX~~ New Service Com. 3-16-49

Location

Date	Material	Amount	Total	Date	Amount
Feb. 25, '49	Labor	10 90	10 90	Feb 16 '49	75 00
	10% Overhead		1 09	Mar 17 '49	17 91
	60' - 3/4" Copper Tubing @.27		16 20		55 09
	1 - 3/4" C x 1/2" I.W.H. S&W		3 15	Feb. 25, '49	9 00
	Littlefield Shovel 3 hrs.		21 00	10' - 3/4" Copper Tubing @.27	2 70
	Trucking 1 hr. @.75		75	1 - 3/4" C Corp-cock	3 00
	Patching 2 x 3		2 00	1 - 3/4" C x 3/4" C Curb-cock	3 68
			55 09	1 - Box & Rod	3 55
				1 - 1/2" Offset Tail Piece	30
				1 - 1/2" Straight Tail Piece	30
				Littlefield Shovel 1 hr.	7 00
				Trucking 1 hr. @.75	75
	Labor			July 02	30 28
				1" Copper	
				1" Corp	
				1" Curb	
				1x3/4 Red - buffalo box	

DATE _____

TOWN OF LEXINGTON – BOARD OF PUBLIC WORKS

WATER DIVISION

The undersigned applies for a supply of water at No..... St. and hereby agrees to comply with the rules and regulations as now, or at any future time, established by the Board of Selectmen.

Am't of Estimate \$.....

Owner


Am't Paid \$.....

Address

Builder

.....

Sketch of Service Here

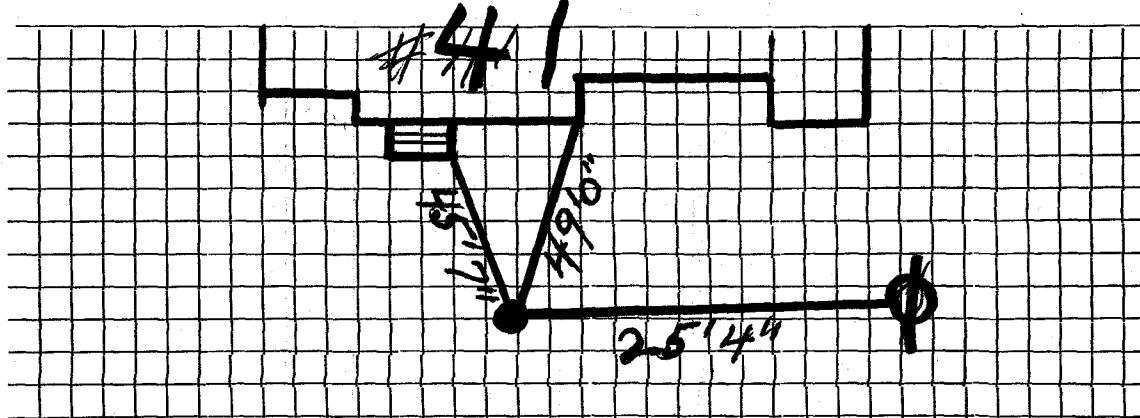

Connection made in Street.

Work completed19


Remarks:

DATE _____

TOWN OF LEXINGTON — BOARD OF PUBLIC WORKS

WATER DIVISION

Sketch of Service Here

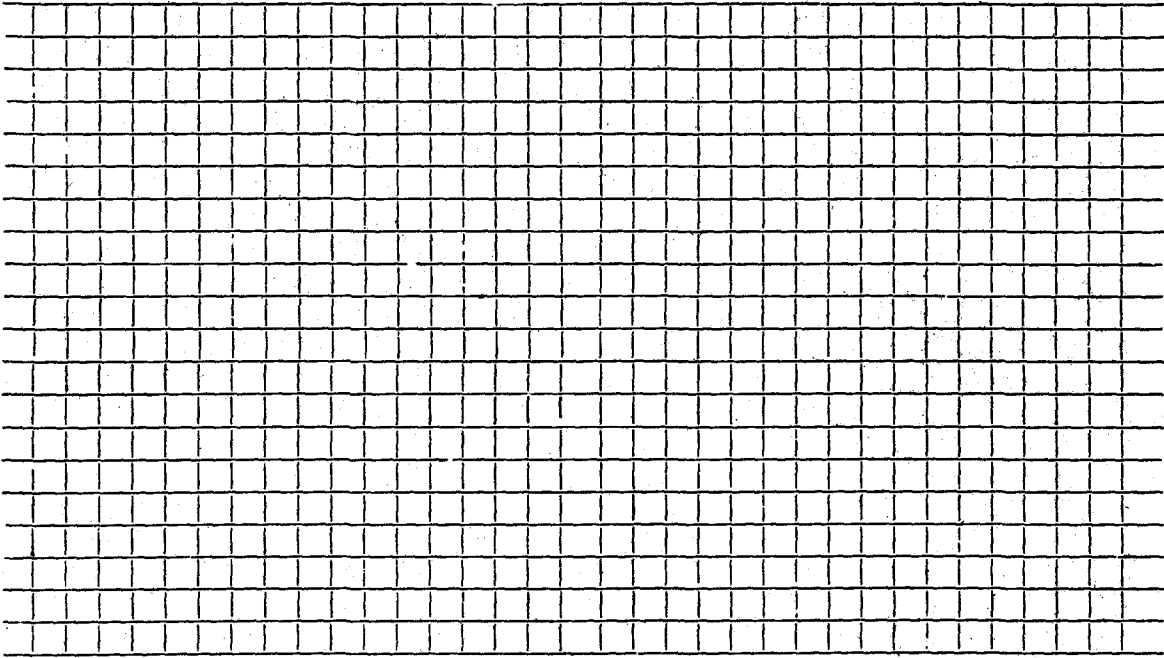

Connection made in Street. Work completed

Remarks:
.....
.....