

WATER SERVICE RECORD

#5789
#6353

Name Donald R. Green

Service No. #19

Address 43 Spring Street

Location

~~XXXXXXXXXX~~ - New Service WO #7100

Comm 6-25-62


Date	Material	Amount	Total	Date	Amount	
4-12-62	Labor	2.13		3-30-62	Deposit	50.00
	10% O.H.	.21	2.34	4-25-62	Refund	9.68
70'	3/4" Copper tubing @.42		29.40			40.32
1	3/4" Cx 1/2 I/W.H. Stop & Waste		6.17			
1	3/4" C3 Part Union		2.41			
			40.32			
				4-12-62	Non-Charge Labor	2.09
				↑ 16'	3/4" Copper tubing @.42	6.72
				1	3/4" C Corp Cock	4.91
				1	3/4" C Curb Cock	6.28
				1	Box & Rod	4.90
				1	1/2 Straight Tailpiece	.50
				1	1/2 Offset Tailpiece	.50
					had to be on 6" main	25.90
					check for buffer box	

DATE _____

TOWN OF LEXINGTON — BOARD OF PUBLIC WORKS

WATER DIVISION

Sketch of Service Here

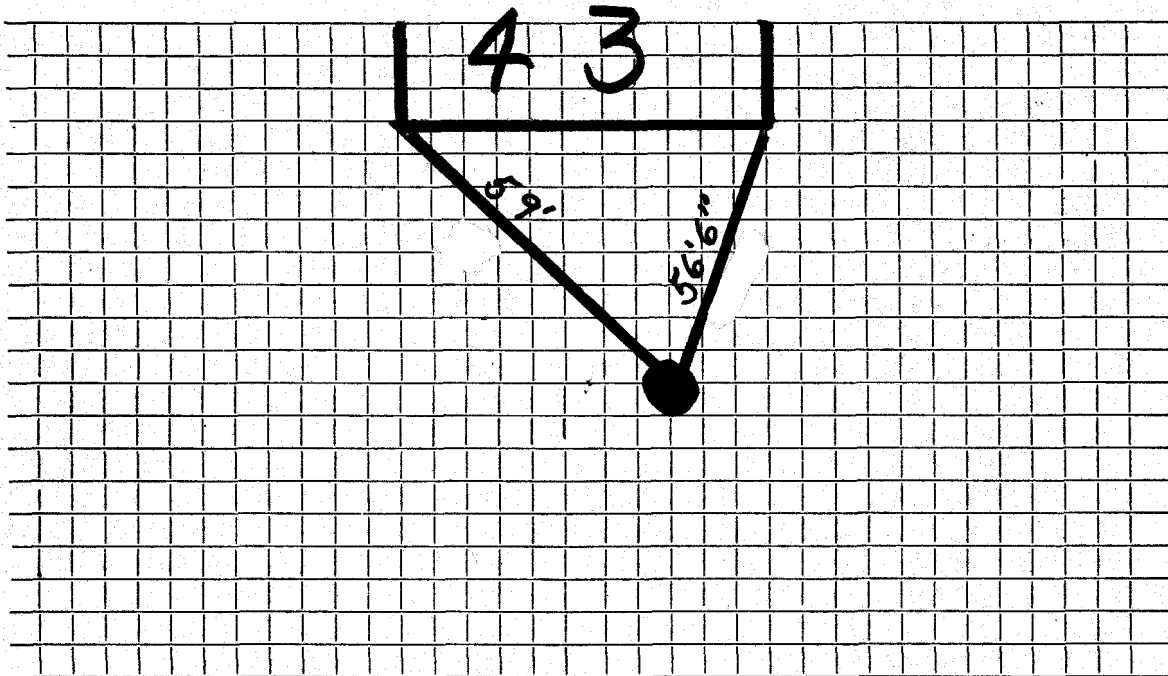

Connection made in Street. Work completed


Remarks:
.....
.....

DATE _____

TOWN OF LEXINGTON — BOARD OF PUBLIC WORKS

WATER DIVISION

Sketch of Service Here

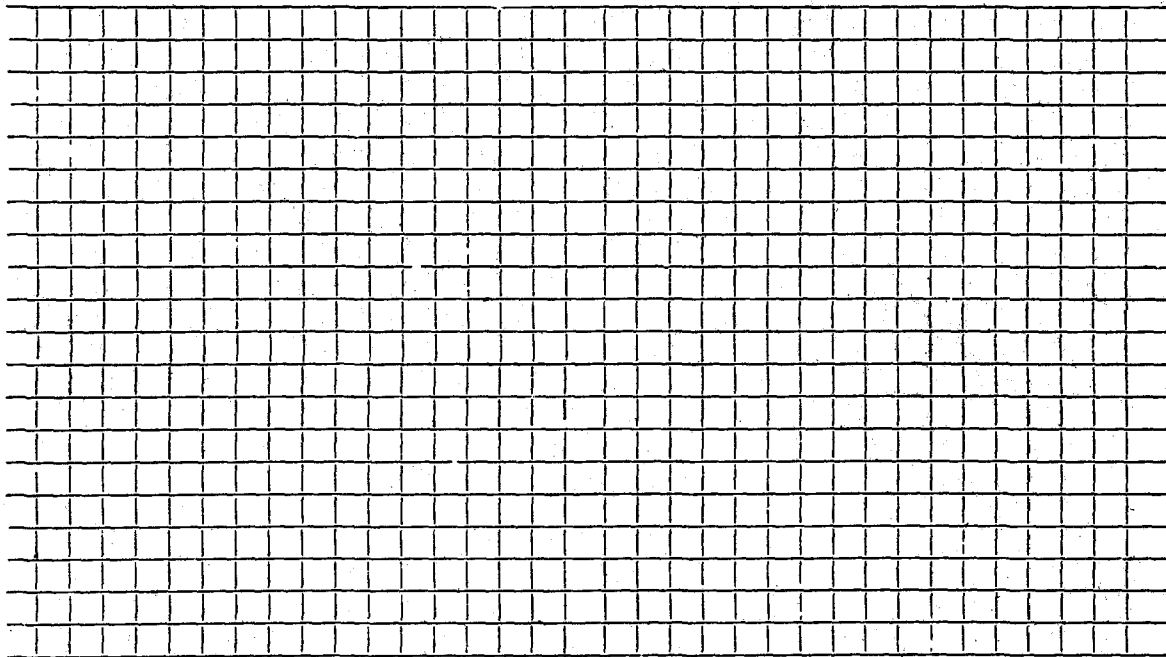

Connection made in Street. Work completed

Remarks:
.....
.....