


DATE _____

TOWN OF LEXINGTON — BOARD OF PUBLIC WORKS

WATER DIVISION

Sketch of Service Here

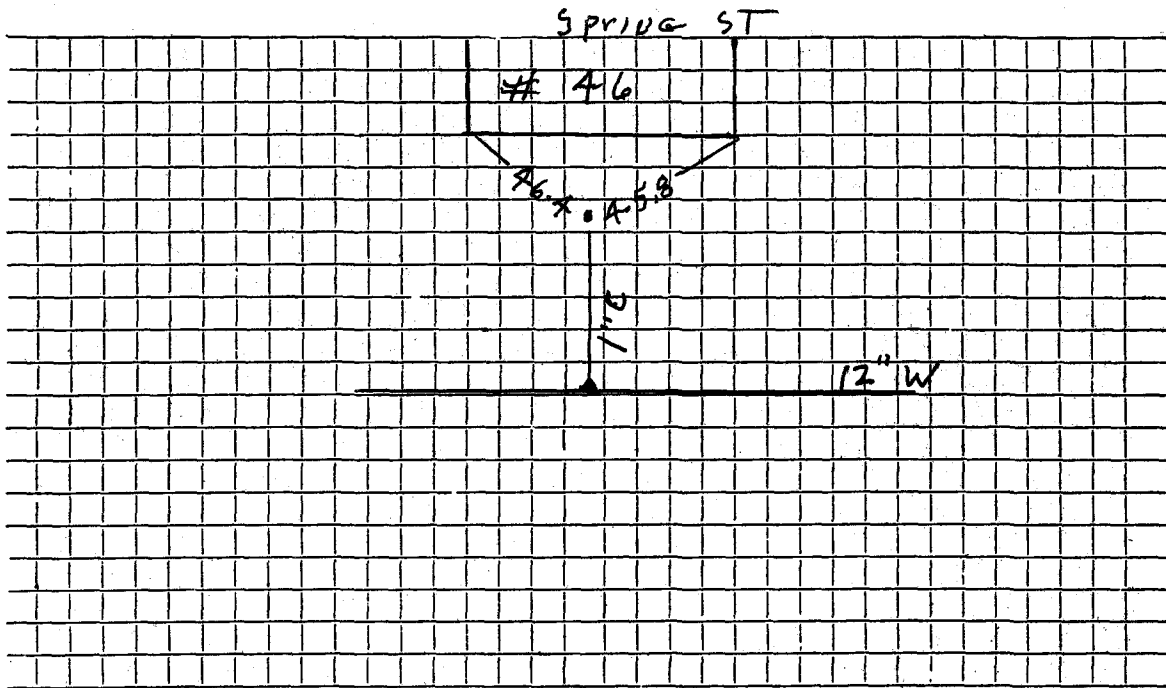

Connection made in Street. Work completed 2003.....

Remarks: 2003 No. INFO. IN. TIME. BOOK. TIME. NEEDED. CHARGED.....