

Name Wilbur R. Fletcher

Service No. 37 3099

Address 47 Spring Street

#3862

Location 47 Spring Street

Kind of Pipe

Size

Size of Main

Repair ~~Renewal~~ New Service

Location

ON 6"

Date

Material

Amount

Total

Date

Amount

Dec. 17, '45

Labor

25 96

25 96

~~Dec. 16 '45~~

~~Deposited~~

50 00

10% Overhead

2 60

~~Dec. 31 '45~~

~~Refunded~~

7 47

50' - 3/4" Copper Tubing

9 55

42 53

1 @ 3/4" C x 1/2" I.W.H. Stop & Waste

2 35

~~Non-Charge~~

Trucking 1 hr.

75

~~Dec. 17, '45~~

~~Labor~~

12 60

Patching

1 32

~~10' - 3/4"~~

~~Copper Tubing~~

1 91

42 53

~~1 - 3/4" C. Corp-cock~~

3 02

~~1 - 3/4" C x 3/4" C. Curb cock~~

3 02

~~1 - Box & Rod~~

1 65

~~1 - 1/2" Offset Tail Piece~~

36

~~Trucking 1 hour~~

75

July 02 '11' 1" Copper

23 31

Labor

~~Demol~~

~~1" Corp~~

~~1" Curb~~

~~1 x 3/4" Rad.~~

~~buff 10 box~~

DATE _____

TOWN OF LEXINGTON—BOARD OF PUBLIC WORKS

WATER DIVISION

The undersigned applies for a supply of water at No. _____ St. and hereby agrees to comply with the rules and regulations as now, or at any future time, established by the Board of Selectmen.


Am't. of Estimate \$ _____

Owner _____

Am't. Paid \$ _____

Address _____

Builder _____

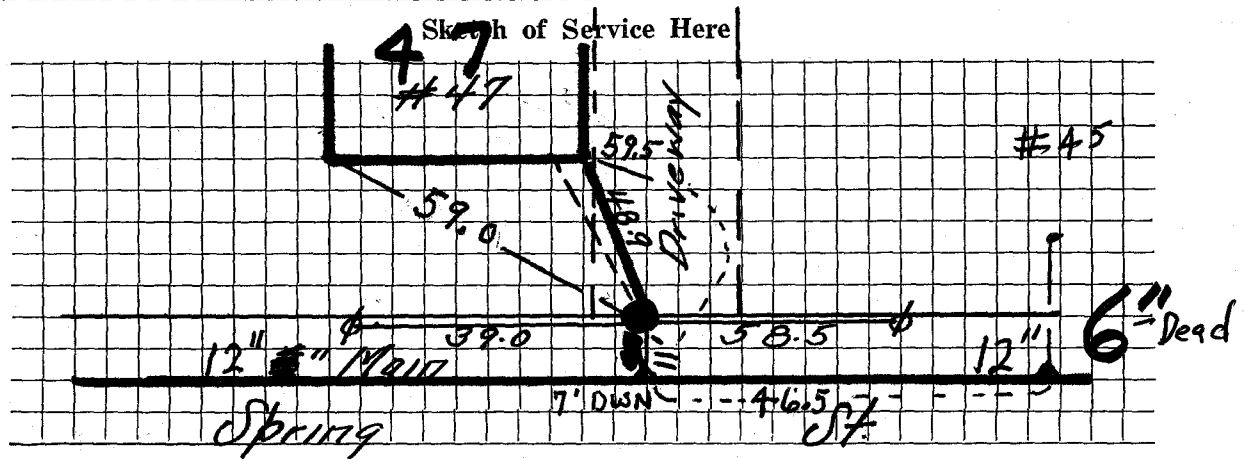

Connection made in _____ Street.

Work completed 2002 19

Remarks: