

WATER SERVICE RECORD

#6085

Name William H. Sullivan

Service No. 140

Address 49 Spring Street

#979

Location

~~XXXXXX~~ New Service W.O. #8337


MAR 23 1964

Date	Material	Amount	Total	Date	Amount	
12-4-63	Labor	2 31		11-22-63	Deposit	50 00
	10% O.H.	23	2 54	9-23-64	Refund	18 19
55'	3/4" Copper Tubing @.42		23 10			31 81
1	3/4" CX 1/2 I.W.H. Stop & Waste		6 17			
			31 81		NON CHARGE	
				12-4-63	Labor	2 13
				9'	3/4" Copper tubing @.42	3 78
				1	3/4" Copper Curb Cock	6 28
				1	3/4" Copper Corp Cock	4 91
				1	Box & Rod	4 90
				1	1/2 Straight Tailpiece	50
				1	1/2 Offset Tailpiece	50
				July 02 14'	1" Copper	23 00
					1" Corp	
					1" Curb	
					1x 3/4 Rod	
					bufflo box	

TOWN OF LEXINGTON — BOARD OF PUBLIC WORKS

WATER DIVISION

Sketch of Service Here

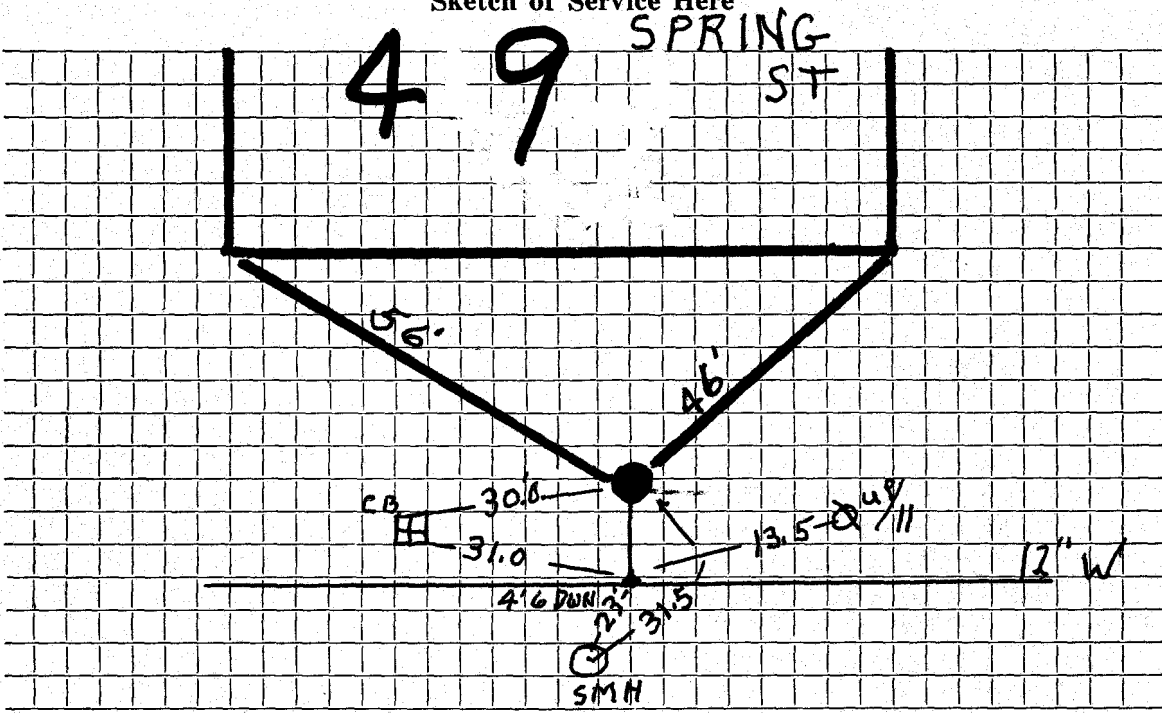

Connection made in Street. Work completed 2002

Remarks:
.....
.....