

Name **Vernon Wilkie**

Service No. **2555**

Address **5 Spring St.**

#5

(CHANGED TO 12" MAIN)

Location

**5 Spring St.**

Kind of Pipe

Size

Size of Main

~~RENEW~~—Renewal—~~NEW SERVICE~~ W.O. #6020

Location **MAY 27 1969**

Hadley Press, Inc., Lexington

Date	Material	Amount	Total	Date	Amount	
4/17/69	Labor	59 94		4/17/69	Labor	73 51
	10% O.H.	5 99	65 93		10'-Copperpipe .79	7 90
	32'-3/4" copperpipe .79		25 28		1/4 Ton Cold Patch 5.50	1 20
	1-3/4" Wheel Valve		9 30		1-3/4" Curb Cock	11 32
	1 Yd. Loam		3 50		1-3/4" Adaptor	2 76
	2 Hrs. Trucking 3.00		6 00		1 Ton Hot top	5 80
	1 " Shovel		6 50		2 1/2 Hrs Trucking 3.00	7 50
			<u>116 51</u>		1 1/2 " "	1 50
					2 " Shovel 6.50	13 00
					1/2 " Compressor 5.00	2 50
					1/2 " Roller 3.00	1 50
					Trailer	<u>2 00</u>
						130 67
				3-27-69	Deposit	245 00
				5-27-69	Refund	128 49
	Labor					<u>116 51</u>

DATE \_\_\_\_\_

# TOWN OF LEXINGTON—BOARD OF PUBLIC WORKS

## WATER DIVISION

The undersigned applies for a supply of water at No. \_\_\_\_\_ St. and hereby agrees to comply with the rules and regulations as now, or at any future time, established by the Board of Selectmen.

Am't. of Estimate \$ \_\_\_\_\_


Owner \_\_\_\_\_

Am't. Paid \$ \_\_\_\_\_

Address 5 Spring St.

Builder \_\_\_\_\_

Sketch of Service Here

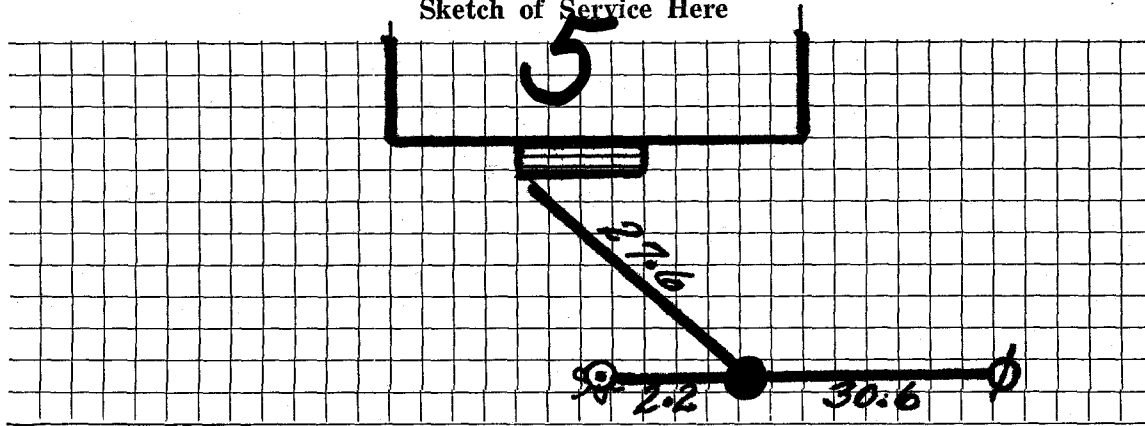

Connection made in \_\_\_\_\_ Street. Work completed \_\_\_\_\_ 19

Remarks: