


DATE _____

TOWN OF LEXINGTON — BOARD OF PUBLIC WORKS

WATER DIVISION

Sketch of Service Here
50 SPRING ST

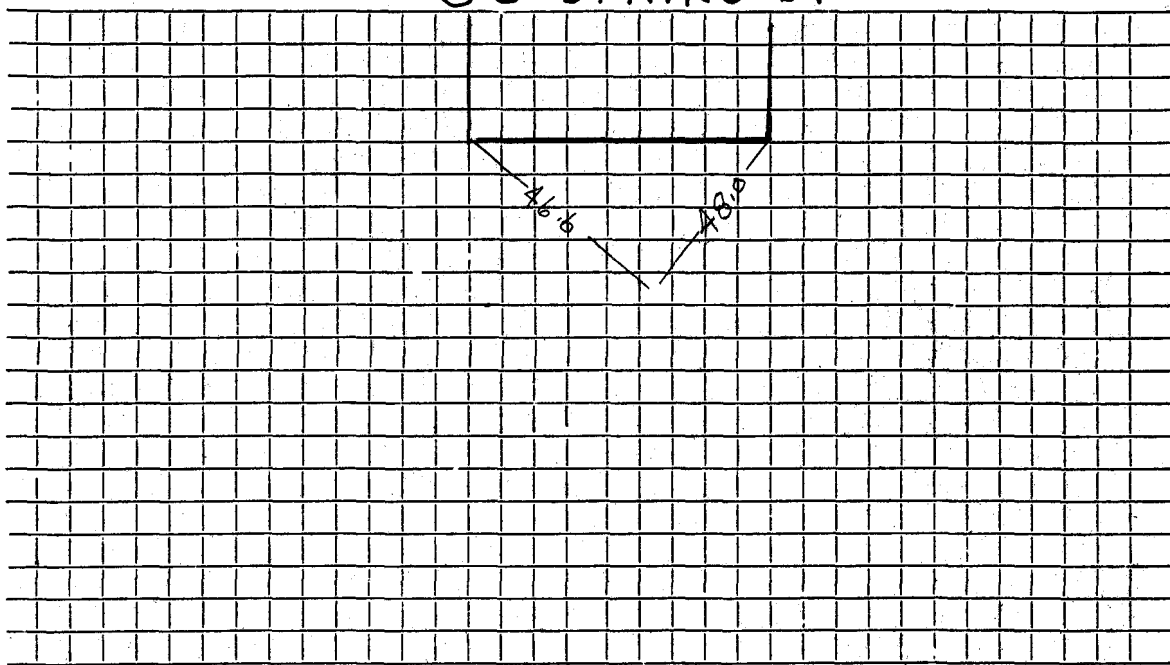

Connection made in Street. Work completed

Remarks: 2002. Ties MAY have changed.
.....
.....