

WATER SERVICE RECORD

#2904

Name Joseph Johnson

Service No. 28

Address 51 Spring Street

Location

~~XXXXXXXXXXXX~~ - New Service

WO# 8647


JUN 29 1964

Date	Material	Amount	Total	Date	Amount
5/27/64	Labor	2 31		4-10-64	30 00
	10% O.H.	23	2 54	4-29-64	1 97
46'	3/4" Copper Tubing @ .42		19 32		28 03
1	3/4" Cx 1/2 I.W.H. Stop & Waste		6 17		
			28 03	5/27/64	2 31
				12'	3/4" Copper Tubing @ .42
				1	3/4" C Corp Cook
				1	3/4" C Curb Cook
				1	Bow & Rod
				1	1/2 Straight Tailpiece
				1	1/2 Offset Tailpiece
					24 44

July 02 12.5
 1" Copper
 1" Corp
 1" Curb Stop
 1" x 3/4 Red
 baffle box

TOWN OF LEXINGTON — BOARD OF PUBLIC WORKS
WATER DIVISION

Sketch of Service Here

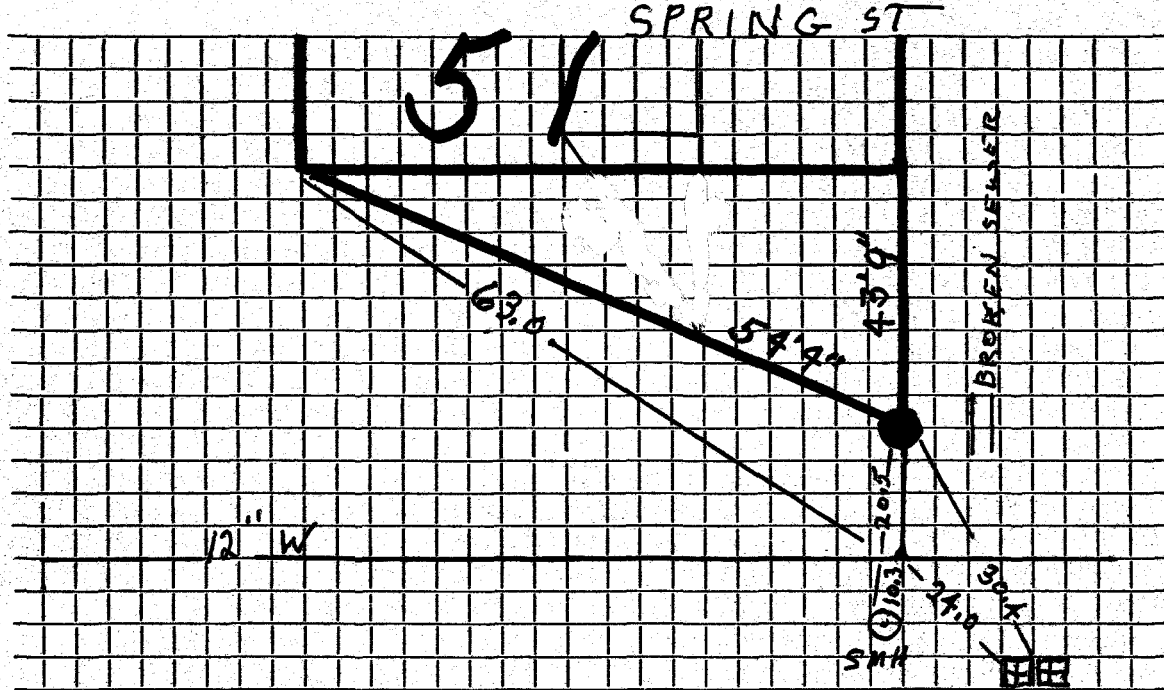

Connection made in Street.

Work completed July 2002 Demi.....

Remarks:
.....
.....