

WATER SERVICE RECORD

Name Martha Kermatti

Service No. 7

Address 53 Spring Street

Location

~~Repair Renewal~~ - New Service W.O. #375 Richard Noyes #3383

MAY 21 1979


Date		Material	Amount	Total	Date	Amount
5-7-79		Labor	17.89		4-23-79	Deposit 150.00
5-8-79		"	25.18			
5-8-79		Police	45.50	88.57		152.84
		10% O.H.		8.86	July 02 11'	1" Copper
10 1/2'		3/4" Copper tubing @.74		7.77		1" Corp
1		3/4" Curb Stop		16.12		1" Curb Stop
1		3/4" Corp. Stop		11.27		1x 3/4 Red.
1		Box & Rod		11.00		Buffle box
1		hr. Trucking @3.00		3.00		
1 1/2		hr. Compressor @5.00		6.25		
				152.84		
5-15-79	49'	3/4" Copper tubing				

DATE _____

TOWN OF LEXINGTON — BOARD OF PUBLIC WORKS

WATER DIVISION

Sketch of Service Here

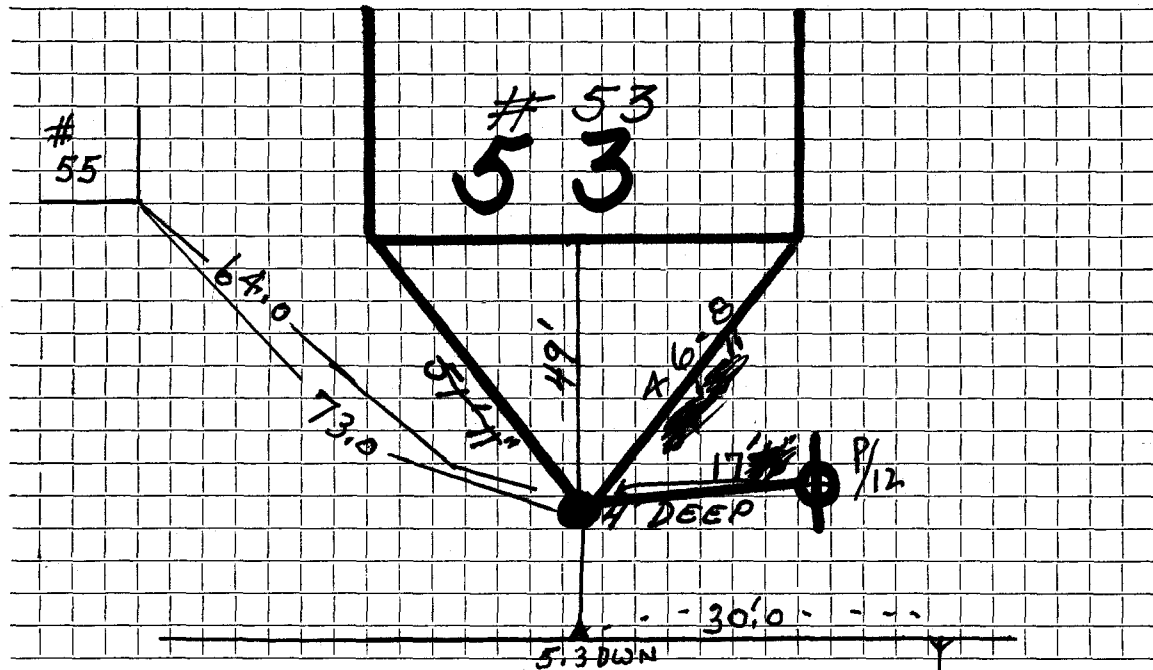

Connection made in Street. Work completed

Remarks: #54