

WATER SERVICE RECORD

#6289

Name Robert Ericson

Service No. 17

Address 57 Spring Street

Location 57 Spring ST.

Repair—Renewal—New Service
XXXXXX XXXXXXXXXXXX

W. O. # 9610

FEB 12 1973


Date	Material	Amount	Total	Date	Amount
6/7/72	Labor	28 98		4/24/72	Deposit 225 00
	10% O.H.	2 90	31 88	2/12/73	Refund 141 84
	50' 3/4" Copper pipe .79		39 50		83 16
	1 Coupling		2 28		
	1 Hr. Trucking		3 00		
	1 Hr. Shovel		6 50	6/7/72	<u>OUTSIDE</u>
			83 16		Labor 57 96
				11'	3/4" Copper pipe .79 8 69
				1	Adaptor 2 91
				1	3/4" Curb cock 11 32
				1/2	Ton cold patch 8.00 2 00
				1	Hr. Trucking 3 00
				2	Hrs. Shovel 4.00 8 00
					<u>93 88</u>
					DEMI
				July 02 1966	1" Copper
					1" COPP
					1" Curb STOP
					1x 3/4 Red
					buffalo box

DATE _____

TOWN OF LEXINGTON — BOARD OF PUBLIC WORKS

WATER DIVISION
SPRING ST

Sketch of Service Here

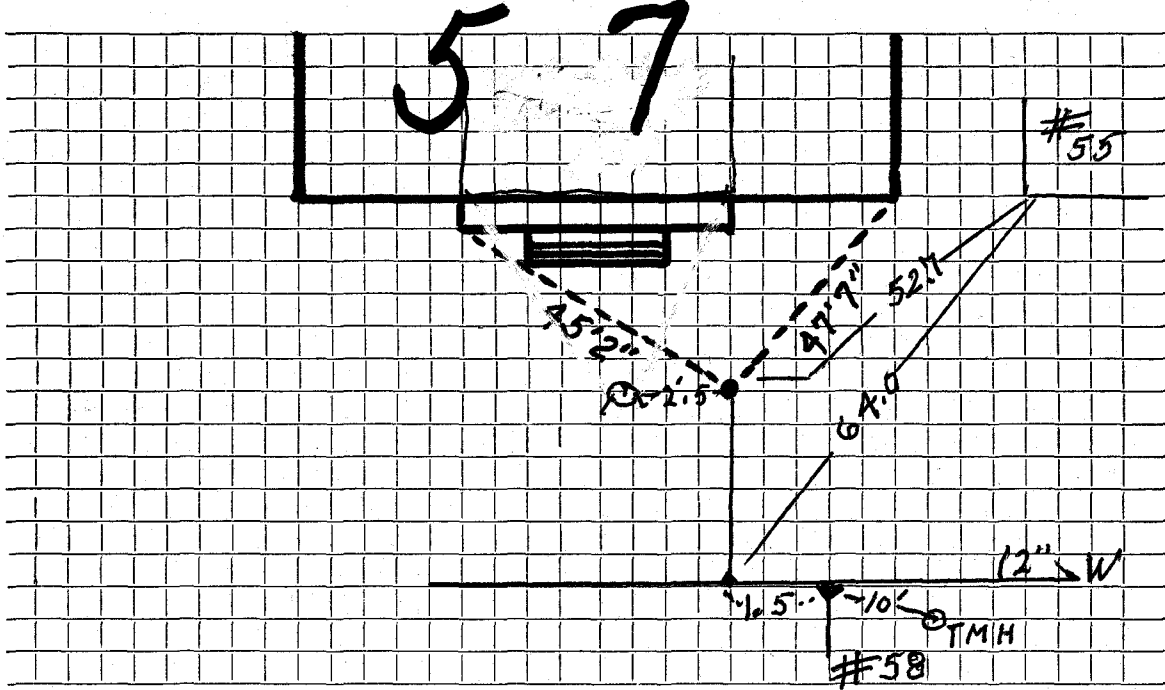

Connection made in Street. Work completed 2002

Remarks: Original Service 3-1-27 Ties From #57 MAY have changed.