


TOWN OF LEXINGTON — BOARD OF PUBLIC WORKS

WATER DIVISION

Sketch of Service Here
SPRING ST

61

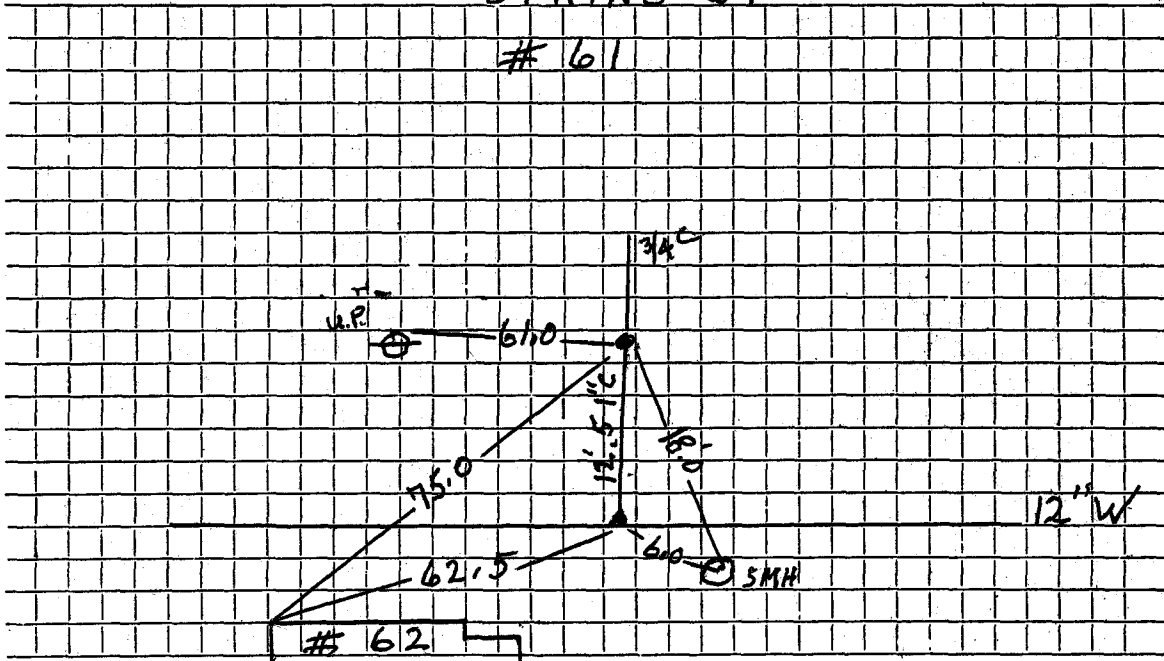

62

Connection made in Street. Work completed 2002 Dem.

Remarks:
.....
.....