

WATER SERVICE RECORD

Name

Service No.

Address

Location 62 SPRING

Repair—Renewal—New Service

ON-12"-W


Date	Material	Amount	Total	Date	Repair	Amount
9-17-'46				6 29 93	2'9" 3/4 COPPER	
	44' 3/4" Copper				1 3 PT COMP UNION	
	1 3/4" X 3/4" I.W.H. Stop + Waste					
				7-9-'46		
					24' 3/4" Copper	
					1 3/4" C. Corp Cock	
					1 3/4" X 3/4" Curb Cock	
					1 Box + Rod	

DATE 6-29-93

TOWN OF LEXINGTON — BOARD OF PUBLIC WORKS

WATER DIVISION

Sketch of Service Here

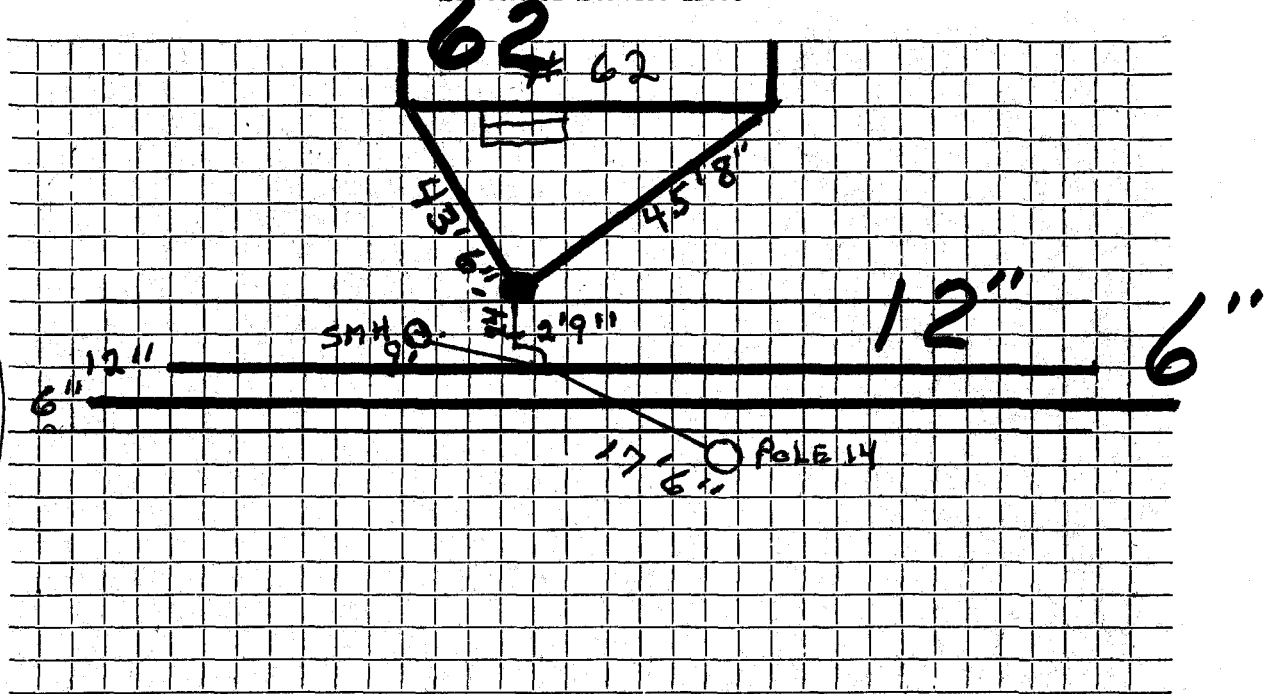

6"-5'8" AT 62  
DEPTH  
12"-5'3"

6"-5'10" AT  
AT 63

Connection made in 12" MAIN SPRING ST Street. Work completed .....

Remarks: ... 3. PART UNION AT 24' .....