

WATER SERVICE RECORD

Service No. 81

Name Robert Adams

Address 63 Spring Street

Location


~~Repair~~—Renewal—~~New Service~~ON 12" W
Comm. 9/30/57

Date	Material	Amount	Total	Date	Amount
5/17/57	Labor	1 76		4-30-57	Deposit \$50 00
	10% overhead	18	1 94	10-18-57	Pd. by ref. on ^{#57} S.A.C. 11 7
	118' - 3/4" Copper tubing @ .4228	49 89			NON CHARGE # 61 7
	1 - 3/4" Cx 1/2 I.W.H. Stop & Waste	4 96		Labor	2 04
	1 hr. Trucking		75		
	1 Nipple		67	10/10/96	4'6"-1" COPPER
	1 - 3/4" C. Union (3 part)		2 27		1" CORPORATION ON 12" MAIN
	1 - 3/4" C. Union (2 part)		1 24		1" x 3/4 Union
			61 72		

TOWN OF LEXINGTON — BOARD OF PUBLIC WORKS

WATER DIVISION

Sketch of Service Here

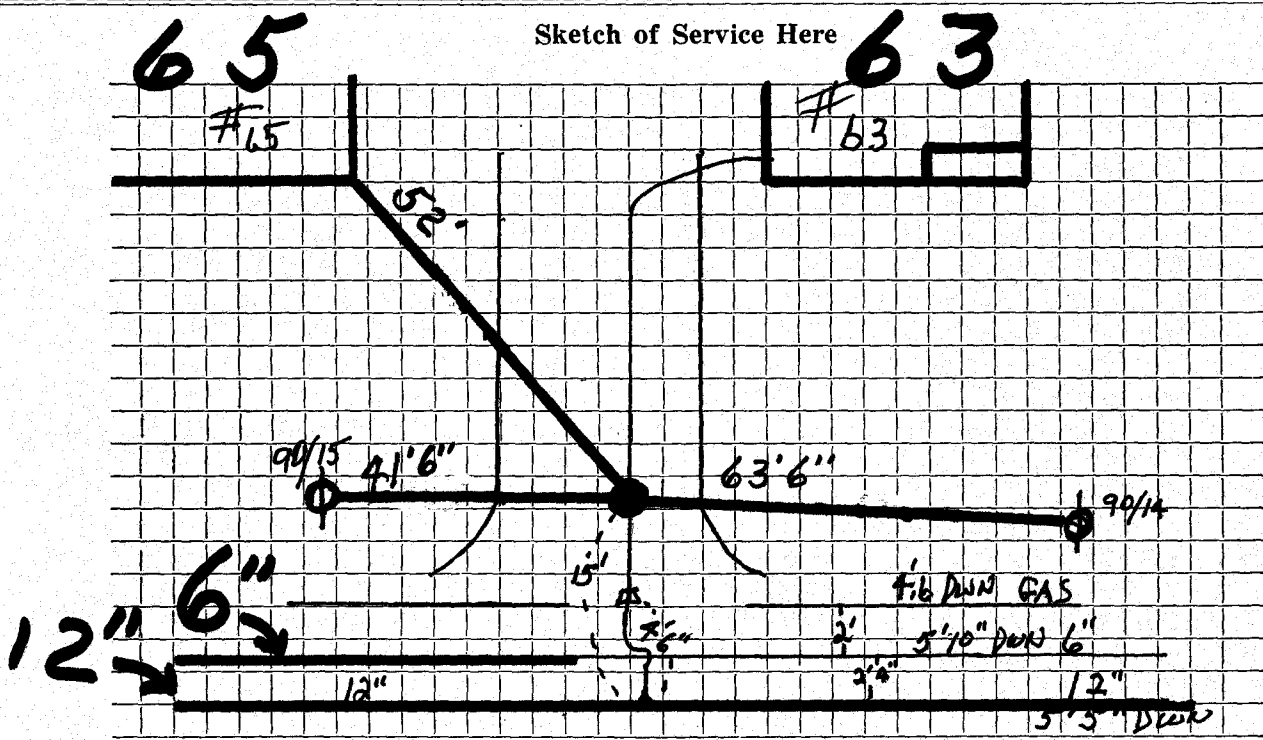

Connection made in 12" SWIMEST Street. Work completed 10/10/96

Remarks: 15' CURB TO CORPORATION (SERVICE UNDER GAS P)