




DATE \_\_\_\_\_

TOWN OF LEXINGTON — BOARD OF PUBLIC WORKS

WATER DIVISION

Sketch of Service Here

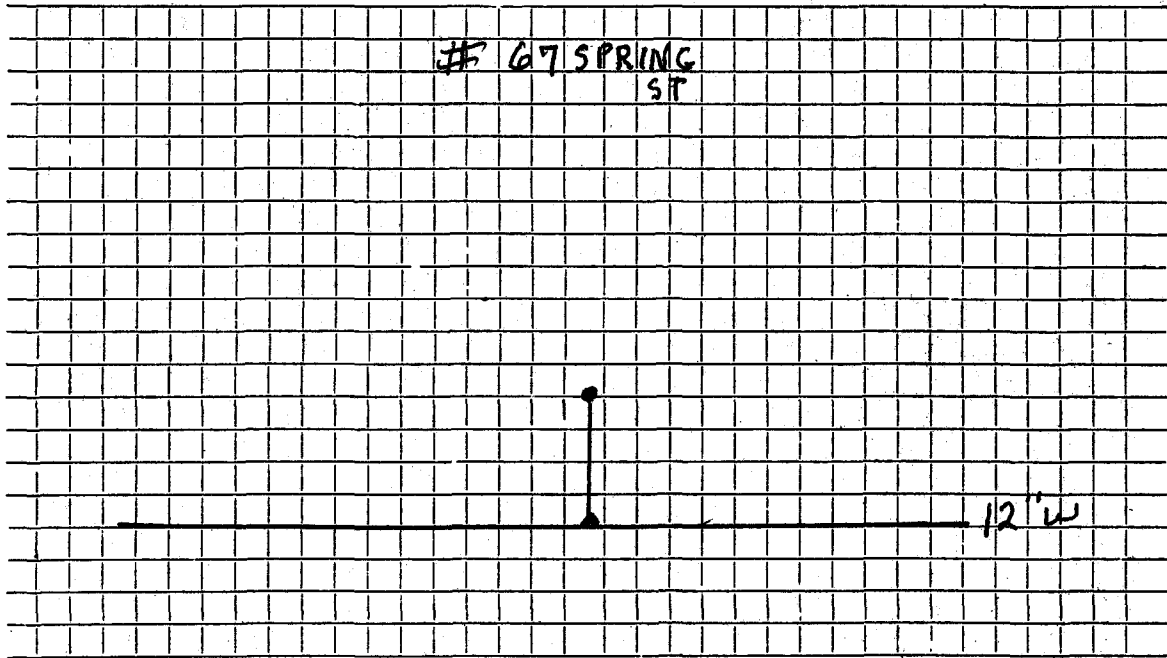

Connection made in ..... Street. Work completed July 2007. Demolished .....

Remarks: NOT IN T.M.S. book. ....  
.....  
.....