

Name William Fellman

Service No.

283

Address 7 Spring Street

Lexington, Mass.

Location 7 Spring Street

Kind of Pipe

CHANGED TO 12" MAIN

Size of Main

~~Repair~~ ~~Renewal~~ New Service

Location

Date	Material	Amount	Total	Date	Amount
Dec. 8, '48	Labor	3 25	3 25	Dec 8 '48	40 00
	10% Overhead		33	Dec 31 '48	6 08
	37' - 3/4" Copper Tubing @.255	9 44			83 92
	1 - 3/4" C x 1/2" I.W.H. S&W	3 15		Dec. 8, '48	Labor
	Littlefield Shovel 2 hrs. @7.00	14 00			4 80
	Trucking 1 hr. @.75	75		8' - 3/4" Copper Tubing @.255	2 04
	Patching 33	3 00		1 - 3/4" Corp-cock	3 00
			33 92	1 - 3/4" C x 3/4" C Curb-cock	3 68
				1 - Box & Rod	3 55
				1 - 1/2" Offset Tail Piece	30
				1 - 1/2" Straight Tail Piece	30
				Littlefield Shovel 1 hr. @.7.00	7 00
				Trucking 1 hr. @.75	75
	Labor				25 42

DATE _____

TOWN OF LEXINGTON - BOARD OF PUBLIC WORKS

WATER DIVISION

The undersigned applies for a supply of water at No..... St. and hereby agrees to comply with the rules and regulations as now, or at any future time, established by the Board of Selectmen.

Am't of Estimate \$.....

Owner


Am't Paid \$.....

Address

Builder

.....

Sketch of Service Here

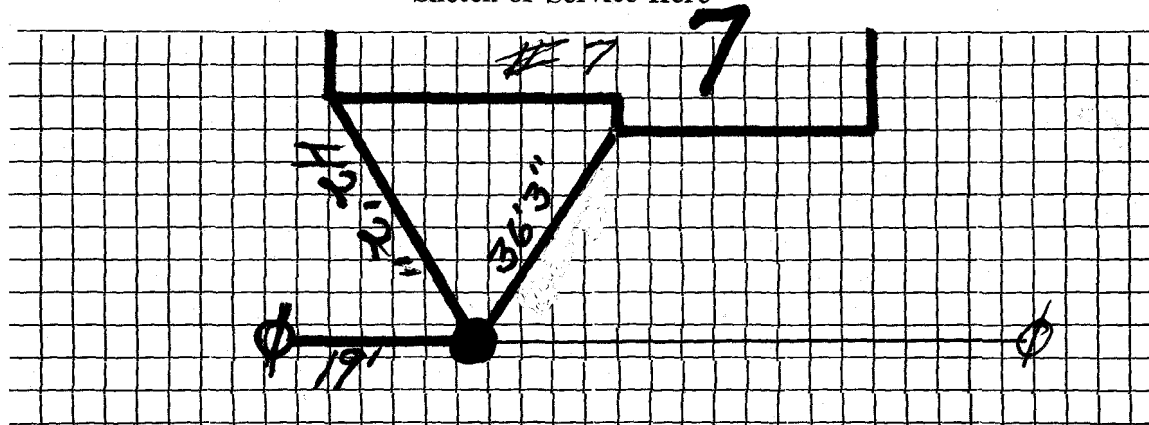

Connection made in Street.

Work completed19

Remarks: