




DATE \_\_\_\_\_

TOWN OF LEXINGTON — BOARD OF PUBLIC WORKS

**WATER DIVISION**

Sketch of Service Here

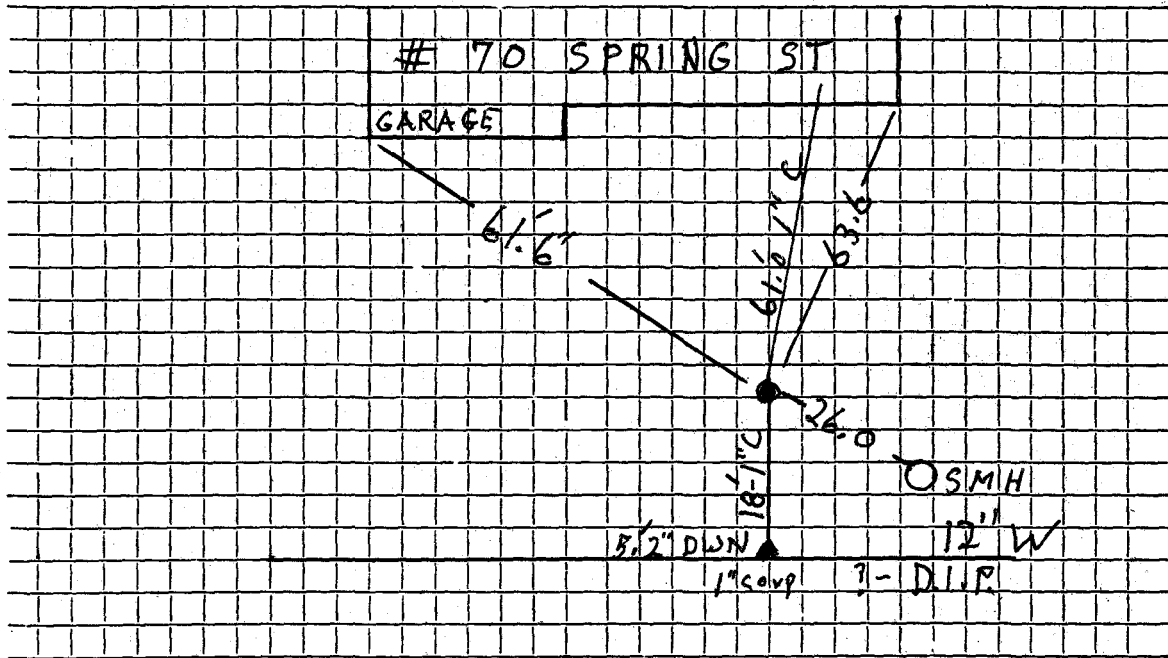

Connection made in SPRING ST, DEMI- July 02 Street.

Work completed 8/19/05 J. McLaughlin

Remarks: .....

.....

.....