

WATER SERVICE RECORD

#176

Name Dianne Estates Inc.

Service No. 124

Address 71 Spring Street

Location

~~Repair~~—~~Renewal~~—New Service


Comm 12-8-58

Date	Material	Amount	Total	Date	Amount
7/9/58	Labor	3 70		6-24-58	50 00
	10% overhead	37	4 07	12-8-58	17 14
	60' - 3/4" Copper tubing @ .37	22 20			NON CHARGE
	1 - 3/4" Cx 1/2" I.W.H. Stop & Waste	5 84			32 86
	1 hr. Trucking		75	Labor	3 70
			32 86	10' - 3/4" Copper tubing @ .37	3 70
				1 - 3/4" C. Corp. Cock	4 64
				1 - 3/4" C. Curb Cock	6 03
				1 Box & Rod	5 00
				1 - 1/2" Straight tailpiece	50
				1 - 1/2" Offset tailpiece	50
					24 07
				July 02 17' 1" Copper	
				1" Corp	
				1" Curb	
				1 1/2" 3/4 Red	
				buffle box	
				* Applied to SA# 112	

TOWN OF LEXINGTON . — BOARD OF PUBLIC WORKS

WATER DIVISION

Sketch of Service Here
SPRING ST

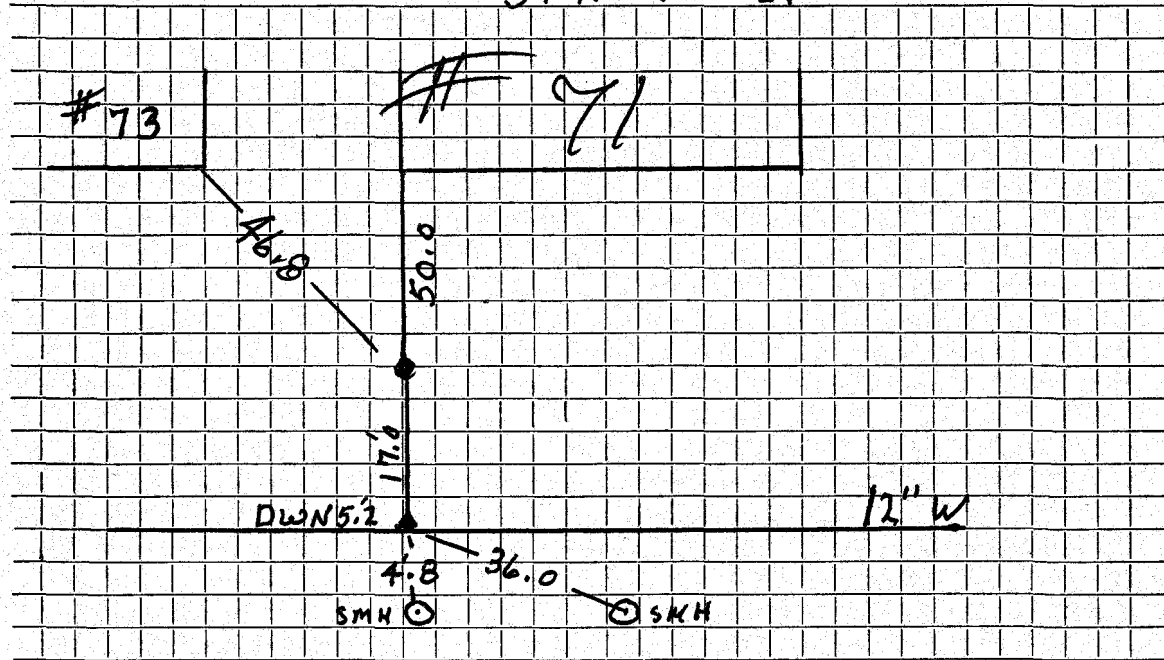

Connection made in Street. Work completed *2002 July Done*.....

Remarks:
.....
.....