

WATER SERVICE RECORD

1398

Name Robert Ericson

Service No. 149

Address 73 Spring Street


Location 73 Spring Street Permit #196 ~~6434~~~~Repair - Renewal~~ New Service W.O. #9396

FEB 15 1965

Date	Material	Amount	Total	Date	Amount
12-17-64	Labor	4 73		12-7-64	Deposit 50 00
	10% O.H.	47	5 20	2-15-65	Retard 10 97
	22" 3/4" Copper Tubing @.42		9 24		39 03
	1 3/4" Corp Cock		5 93	July 02 16'	1" copper
	1 3/4" Curb Cock		7 01		1" Corp
	1 Box & Rod		4 90		1" Curb
	1/2 Hr. Town Shovel @6.50		3 25		1x3/4 Red
	1/2 Hr. Loader @4.00		2 00		3 off 1. box
	1/2 Hr. Town Truck @3.00		1 50		
			39 03		
12-23-64					
	44' 3/4" Copper Tubing				

TOWN OF LEXINGTON — BOARD OF PUBLIC WORKS

WATER DIVISION

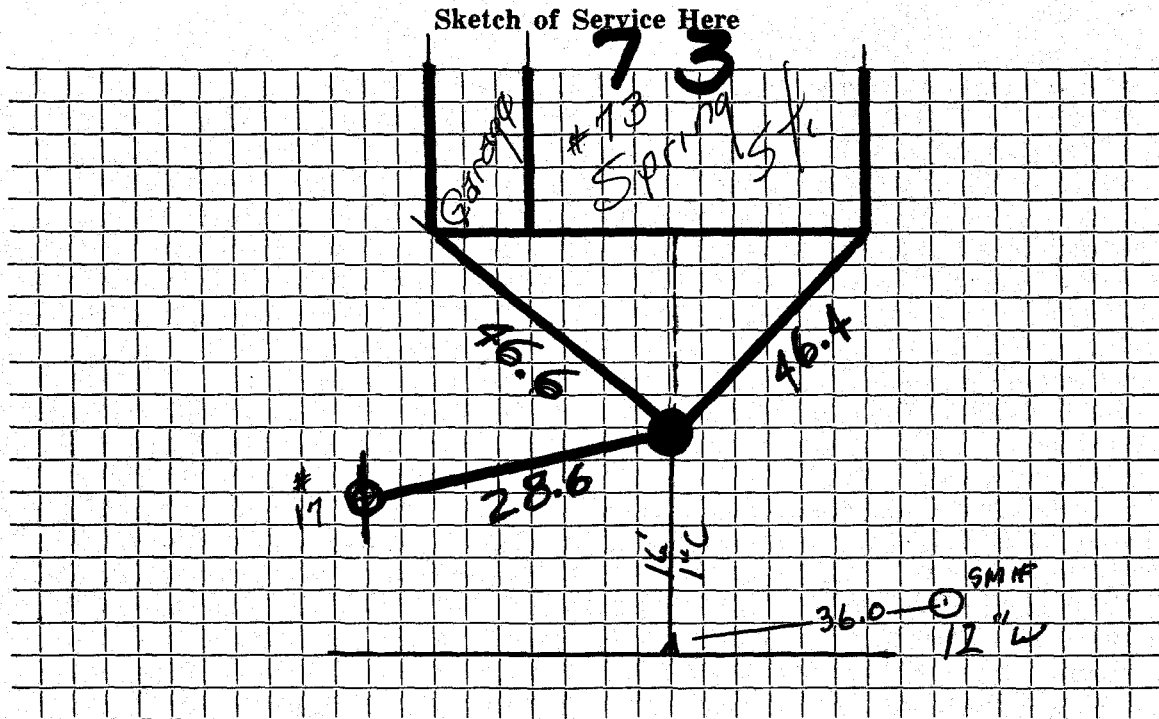

Connection made in Street. Work completed 2002

Remarks:
.....
.....