




TOWN OF LEXINGTON — BOARD OF PUBLIC WORKS  
**WATER DIVISION**

Sketch of Service Here  
**SPRING ST**

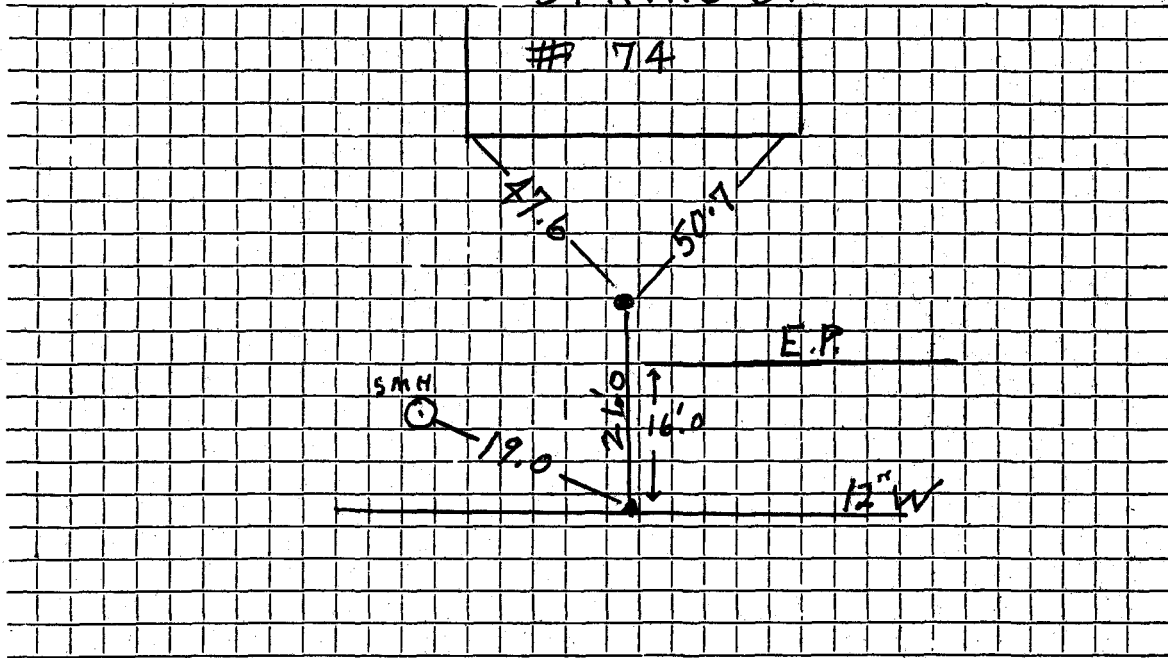

Connection made in ..... Street. Work completed July 2002 Lexi.....

Remarks: .....  
.....  
.....