

WATER SERVICE RECORD

Name _____

Service No.

Address

75 SPRING ST

Location

Repair—Renewal—New Service


DATE _____

TOWN OF LEXINGTON — BOARD OF PUBLIC WORKS

WATER DIVISION

Sketch of Service Here

SPRING ST

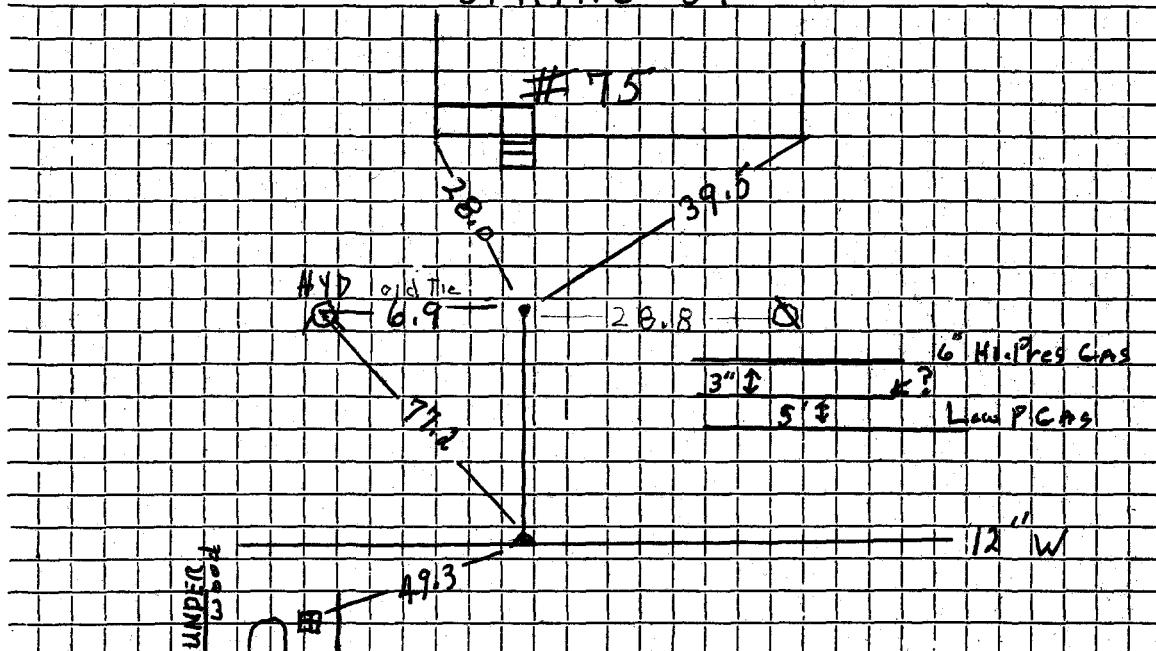

Connection made in Street. Work completed 2002

Remarks: Ties.....