


DATE 9-21-94

TOWN OF LEXINGTON — BOARD OF PUBLIC WORKS
WATER DIVISION

8 Sketch of Service Here

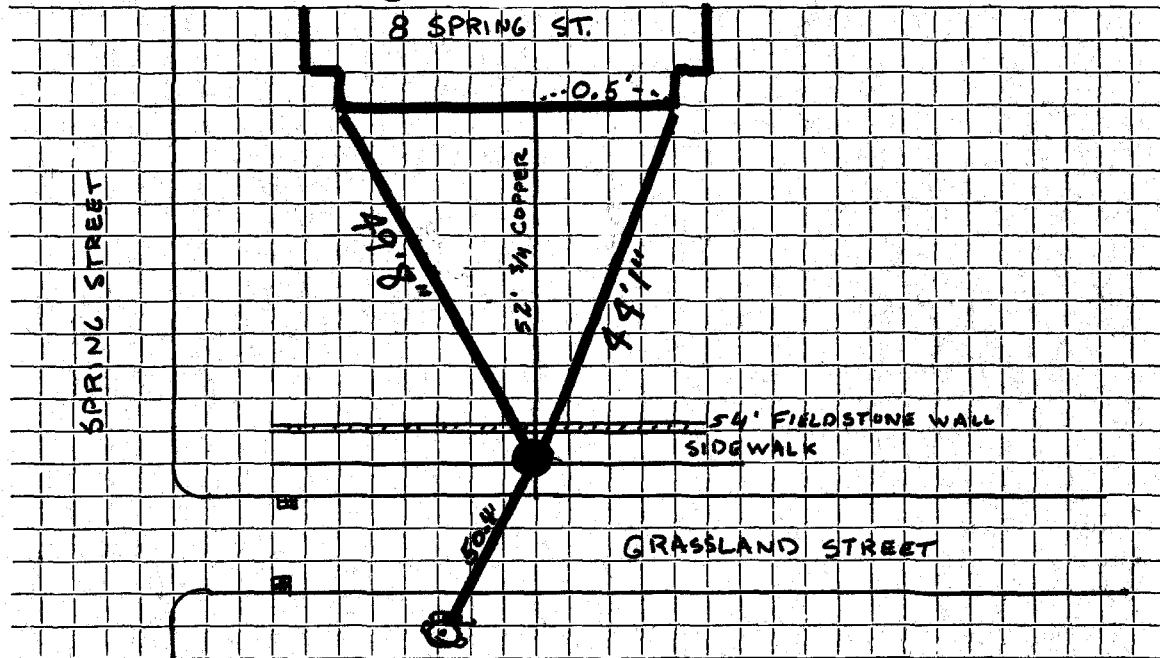

Connection made in ... GRASSLAND ... Street. Work completed

Remarks:

.....


.....

DATE 7-8-1999

TOWN OF LEXINGTON — BOARD OF PUBLIC WORKS

WATER DIVISION

Sketch of Service Here

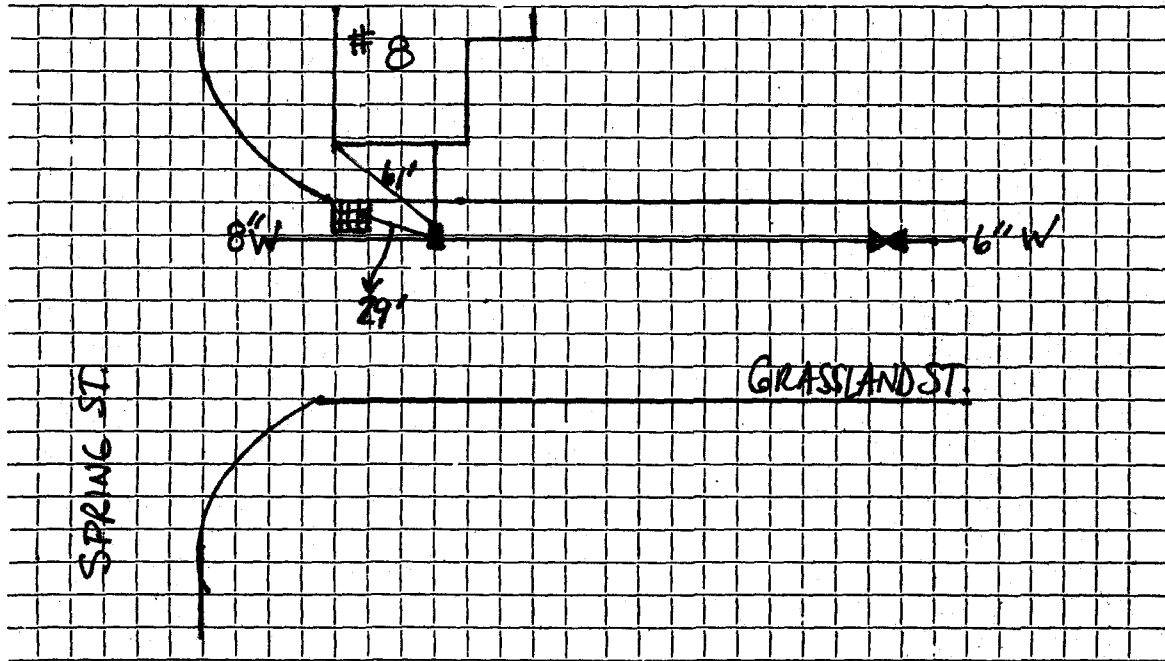

Connection made in 8" PORTION OF MAIN ON GRASSLAND Street.

Work completed NEW CORPORATION, UNION

Remarks: 3/4" COPPER TUBING TO CURB STOP.

WATER SERVICE RECORD

Name F. Rogers

Service No.

Address 8 SPRING STREET

Location

Repair ~~Renewal~~ New Service

BRUCE MCKEE #0382


Date	Material	Amount	Total	Date	Amount
9-21-94	52 LF 3/4" COPPER				
	CURB BOX				
	CURB STOP				
				11-18-'69	
				35' 3/4" Copper	
				1 3/4" C. Curb Cock	
				1 3/4" C. Corp Cock	
				1 3/4" 2 Part Union	
				+ 1" Cement Lined Nipple	
				+ Repair Clamp	
				1 Box + Rod	
				insulation	

DATE 9-21-94

TOWN OF LEXINGTON — BOARD OF PUBLIC WORKS

WATER DIVISION

8 Sketch of Service Here

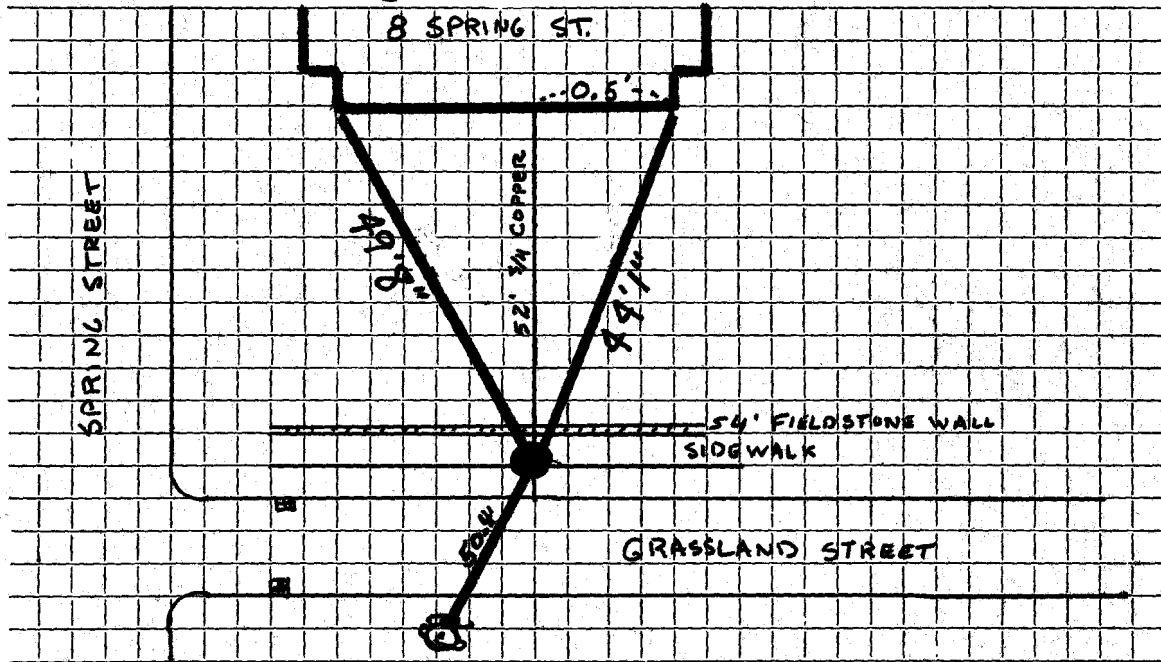

Connection made in ... GRASSLAND ... Street. Work completed

Remarks:
.....
.....