

WATER SERVICE RECORD

Name G. Brandenburg

Service No.

Address 82 SPRING ST

Location

Repair—Renewal—New Service

E.R. Banks #0572


Date	Material	Amount	Total	Date	Amount
12/12 '90	20 LF 3/4" COPPER				
6-28-'46	52' 3/4" Copper			6-27-'46	29' <del>3/4" Copper</del>
	1 3/4" C. X 1/2" I.W.H. STop + Waste				1 <del>3/4" C. Corp Cock</del>
					1 <del>3/4" C. X 3/4" C. Curb Cock</del>
					1 <del>Box + Rod</del>
				July 02 '23	1" Copper
					1" Corp
					1" Curb
					1 X 3/4 Red
					buff lo box

DATE 12/12/98

TOWN OF LEXINGTON — BOARD OF PUBLIC WORKS

WATER DIVISION

Sketch of Service Here

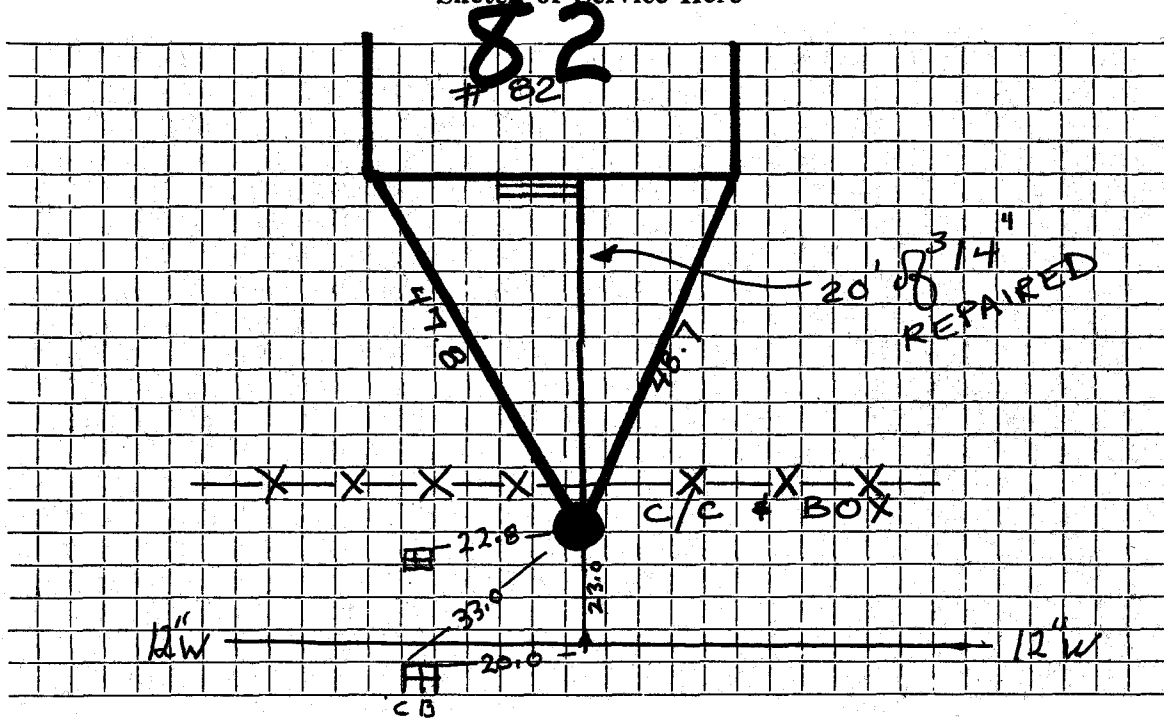

Connection made in SPRING Street. Work completed Dec! 2002

Remarks: Original Service 4L