

WATER SERVICE RECORD

Name Bob Trebino

Service No.

Address 83 SPRING ST

Location

Repair—Renewal—New Service

| Date | Material | Amount | Total | Date | Dem/ Not Used | Amount |
|---------|-------------------|--------|-------|-------------|-----------------------------|--------|
| 7/31/59 | 100' 1" Copper | | | July 02 11' | 1" Copper | |
| | 1 1" 3 part Union | | | NOT IN USE | 1" Corp | |
| | | | | | 1" Curb stop | |
| | | | | | + 3/4 Red | |
| | | | | | buffle box | |
| | | | | | This 3/4 Service feed House | |
| | | | | | 3/4 Copper | |
| | | | | | 3/4 Corp | |
| | | | | | 3/4 Curb stop | |
| | | | | | Box + Red | |
| | | | | | could not Loc Curb 2004 JW | |

TOWN OF LEXINGTON — BOARD OF PUBLIC WORKS


WATER DIVISION

-2002

Sketch of Service Here

83 # 83

WD. SHUT 6" WATER
BEUSE ST. IT HAD WATER

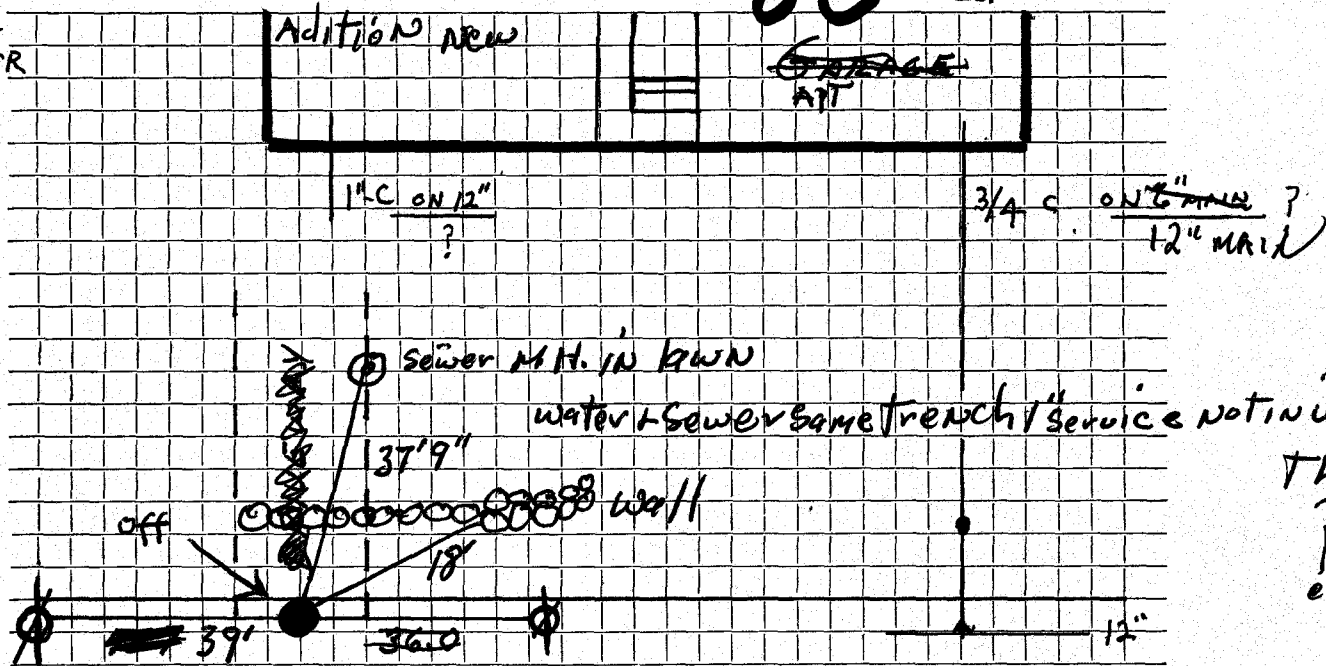

water & sewer same trench / service not in use at this time ?

Connection made in Street. Work completed

Remarks: There is a 3/4" Copper Service into house that is in service?
1" Service shut at curb never used. open end pipe in house.