


DATE _____

TOWN OF LEXINGTON — BOARD OF PUBLIC WORKS

WATER DIVISION

Sketch of Service Here
SPRING ST

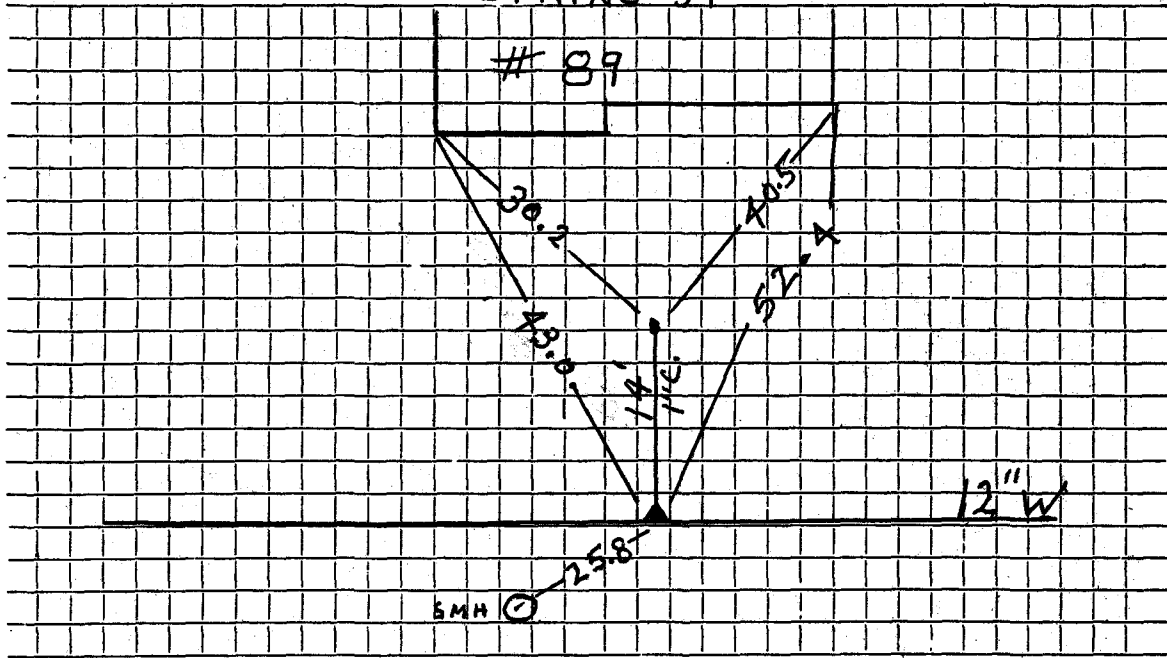

Connection made in Street. Work completed 2003 July

Remarks:
.....
.....