

Name William Fellman

Service No. 105-299

Address 9 Spring Street

CHANGED TO 12" MAIN Location 9 Spring Street

Kind of Pipe

Size

Size of Main

Repairs-Renewal--New Service

Com. 8-15-49

Location

Date	Material	Amount	Total	Date	Amount
June 16, '49	Labor	2 50	2 50	June 13, '49	40 00
	10% Overhead		26		
	40' - 3/4" Copper Tubing @ .24		9 60		30 90
	1 - 3/4" C x 1/2" I.W.H. S&W		3 29	June 16, '49	3 42
	Littlefield Shovel 1 1/2 hrs.		10 50	7' - 3/4" Copper Tubing @ .24	1 68
	Trucking 1 hr. @ .75		75	1 - 3/4" C Corp-cock	3 15
	Patching 4 x 3		4 00	1 - 3/4" C x 3/4" C Curb-cock	3 85
			30 90	1 - Box & Rod	3 95
				1 - 1/2" Offset Tail Piece	37
				1 - 1/2" Straight Tail Piece	37
				Littlefield Shovel 1 hr. @ 7.00	7 00
				Trucking 1 hr. @ .75	75
	Labor				24 54

DATE _____

TOWN OF LEXINGTON - BOARD OF PUBLIC WORKS

WATER DIVISION

The undersigned applies for a supply of water at No..... St. and hereby agrees to comply with the rules and regulations as now, or at any future time, established by the Board of Selectmen.

Am't of Estimate \$.....

Owner'


Am't Paid \$.....

Address

Builder

.....

Sketch of Service Here

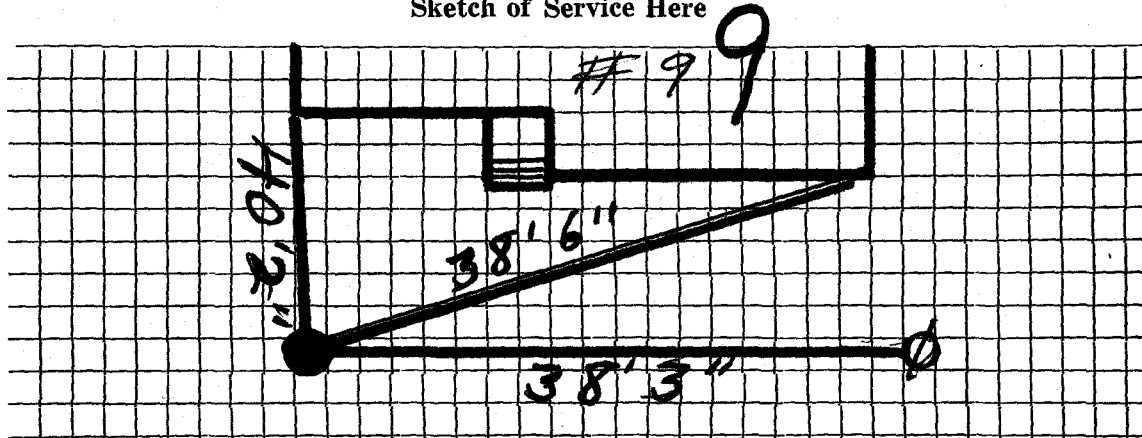

Connection made in Street.

Work completed19

Remarks: